


SECTION

12

TOWNSHIP 39S, RANGE 1E, W. M.

North

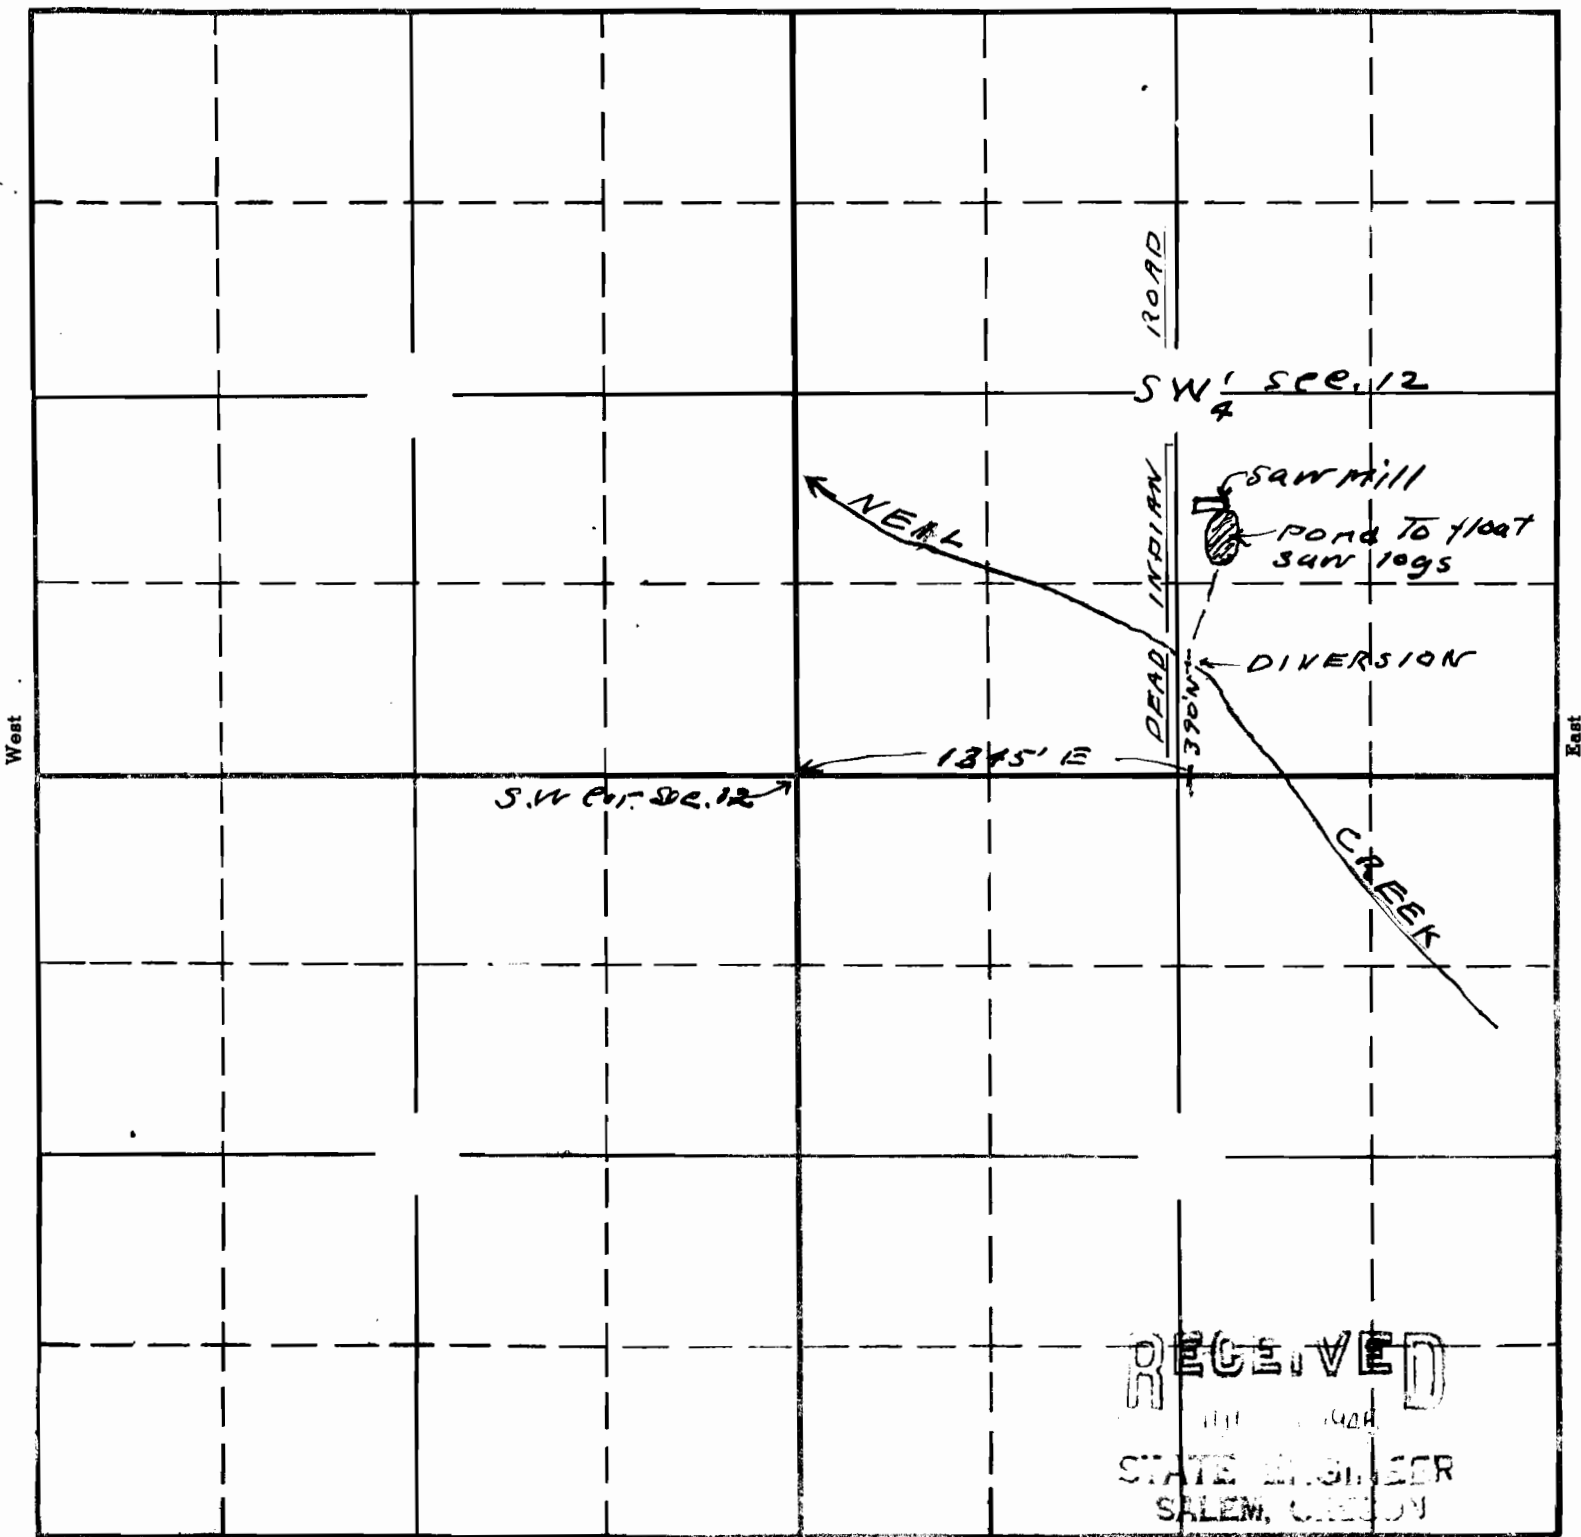

RECEIVED
 1111 1946
 STATE ENGINEER
 SALEM, OREGON

21792 15-24

Map To accompany application
 L F ELAM for use of waters from
 Neel Creek for pond to float
 saw logs

APPLICATION No. 21792
 PERMIT No. 17145

This office 7/6/46