


Permit: S 16391  
Volume: 6A  
Strm: MAPLE G  
Trib: APFLEGATE R  
Priority: 7/02/45

Sec.

Tp. 38 S  
R 5 W

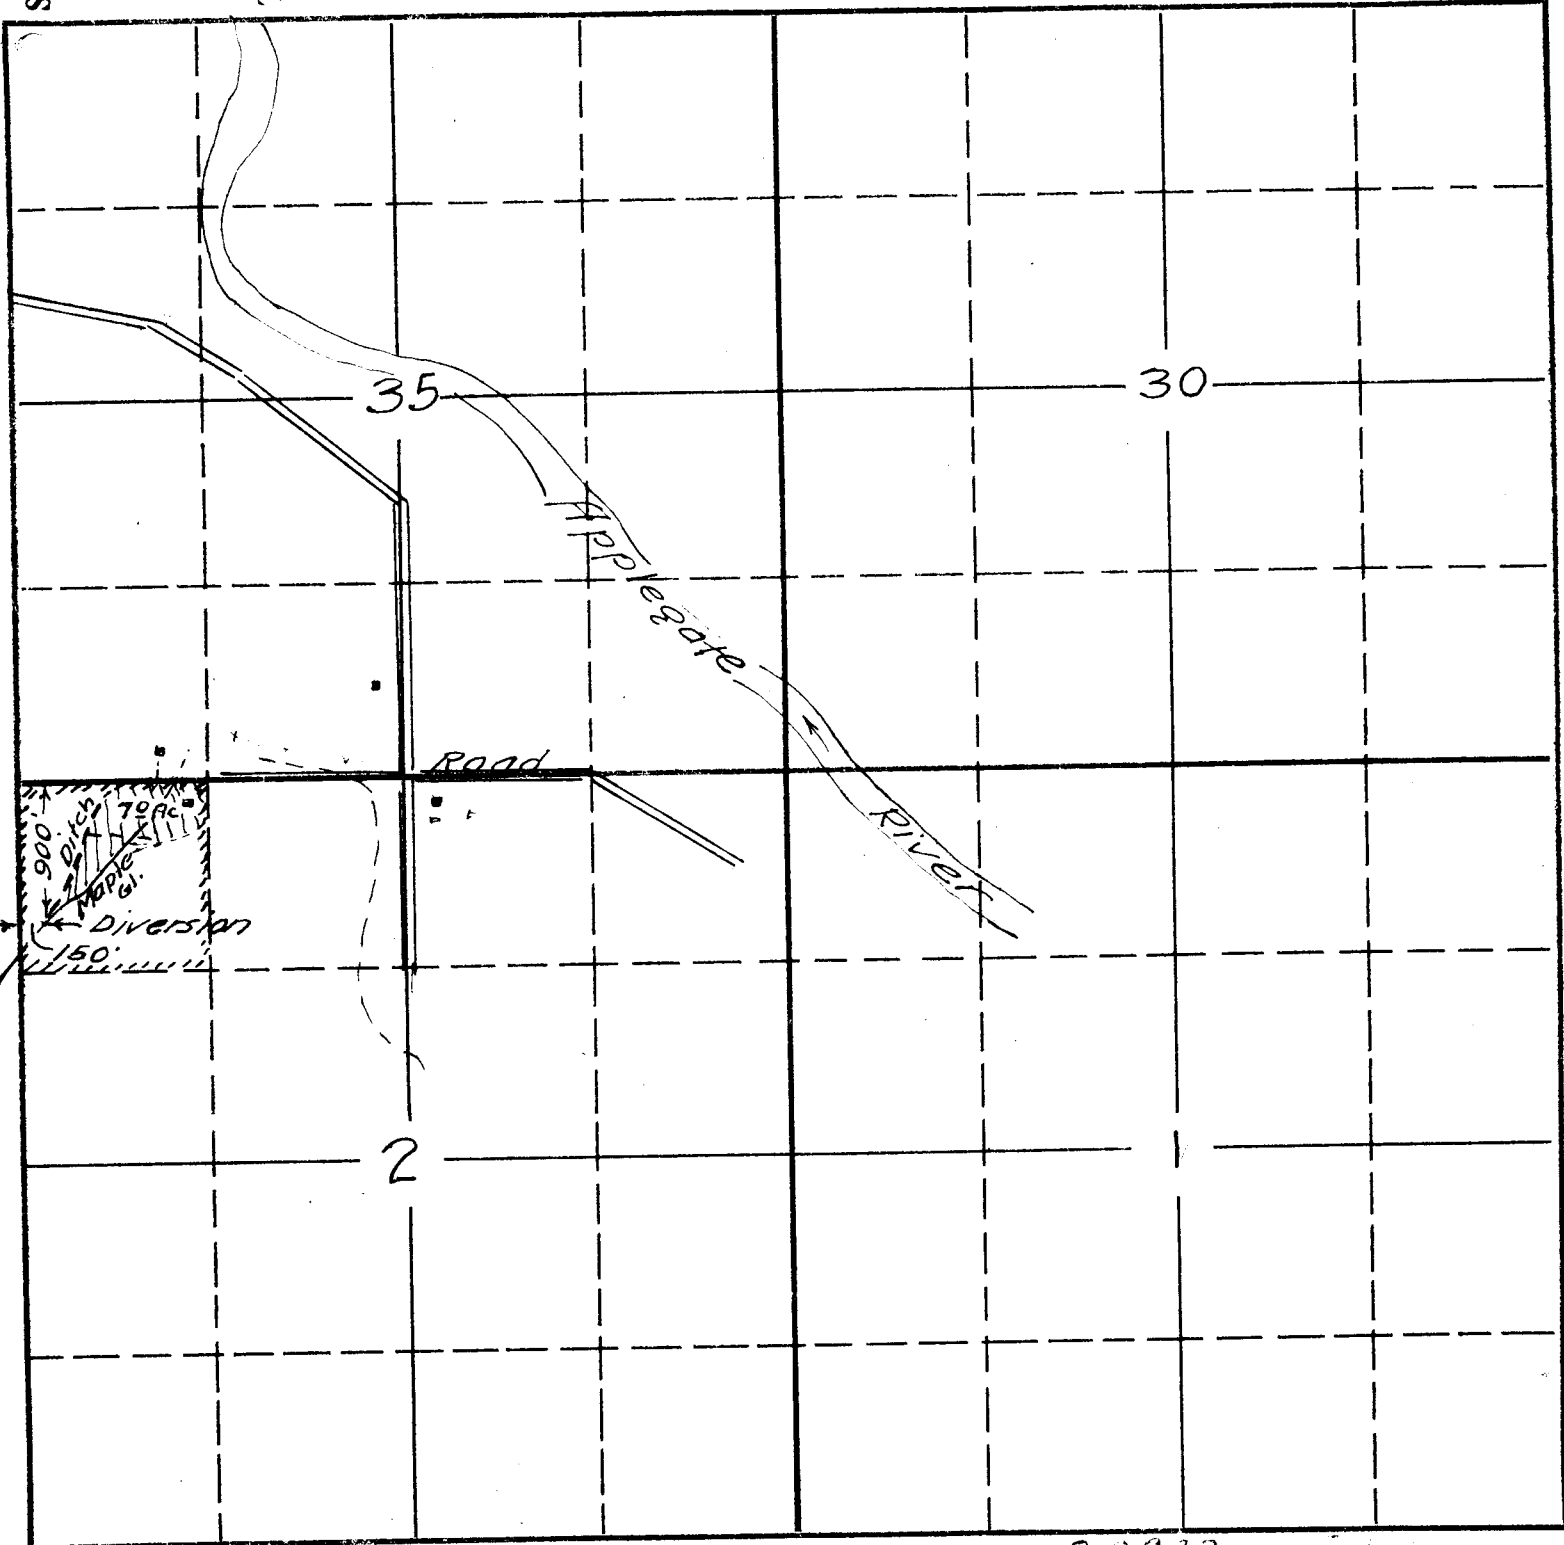

John Crittenden  
June 1945

20933  
Application No. 20733  
Permit No. 16391

JUL 2