


SECTION

Permit: S 17149
Volume: 1A
Strm: BAILEY CR
Trib: ROGUE R
Priority: 7/12/46

TOWNSHIP 34 S., RANGE 8 W.

North

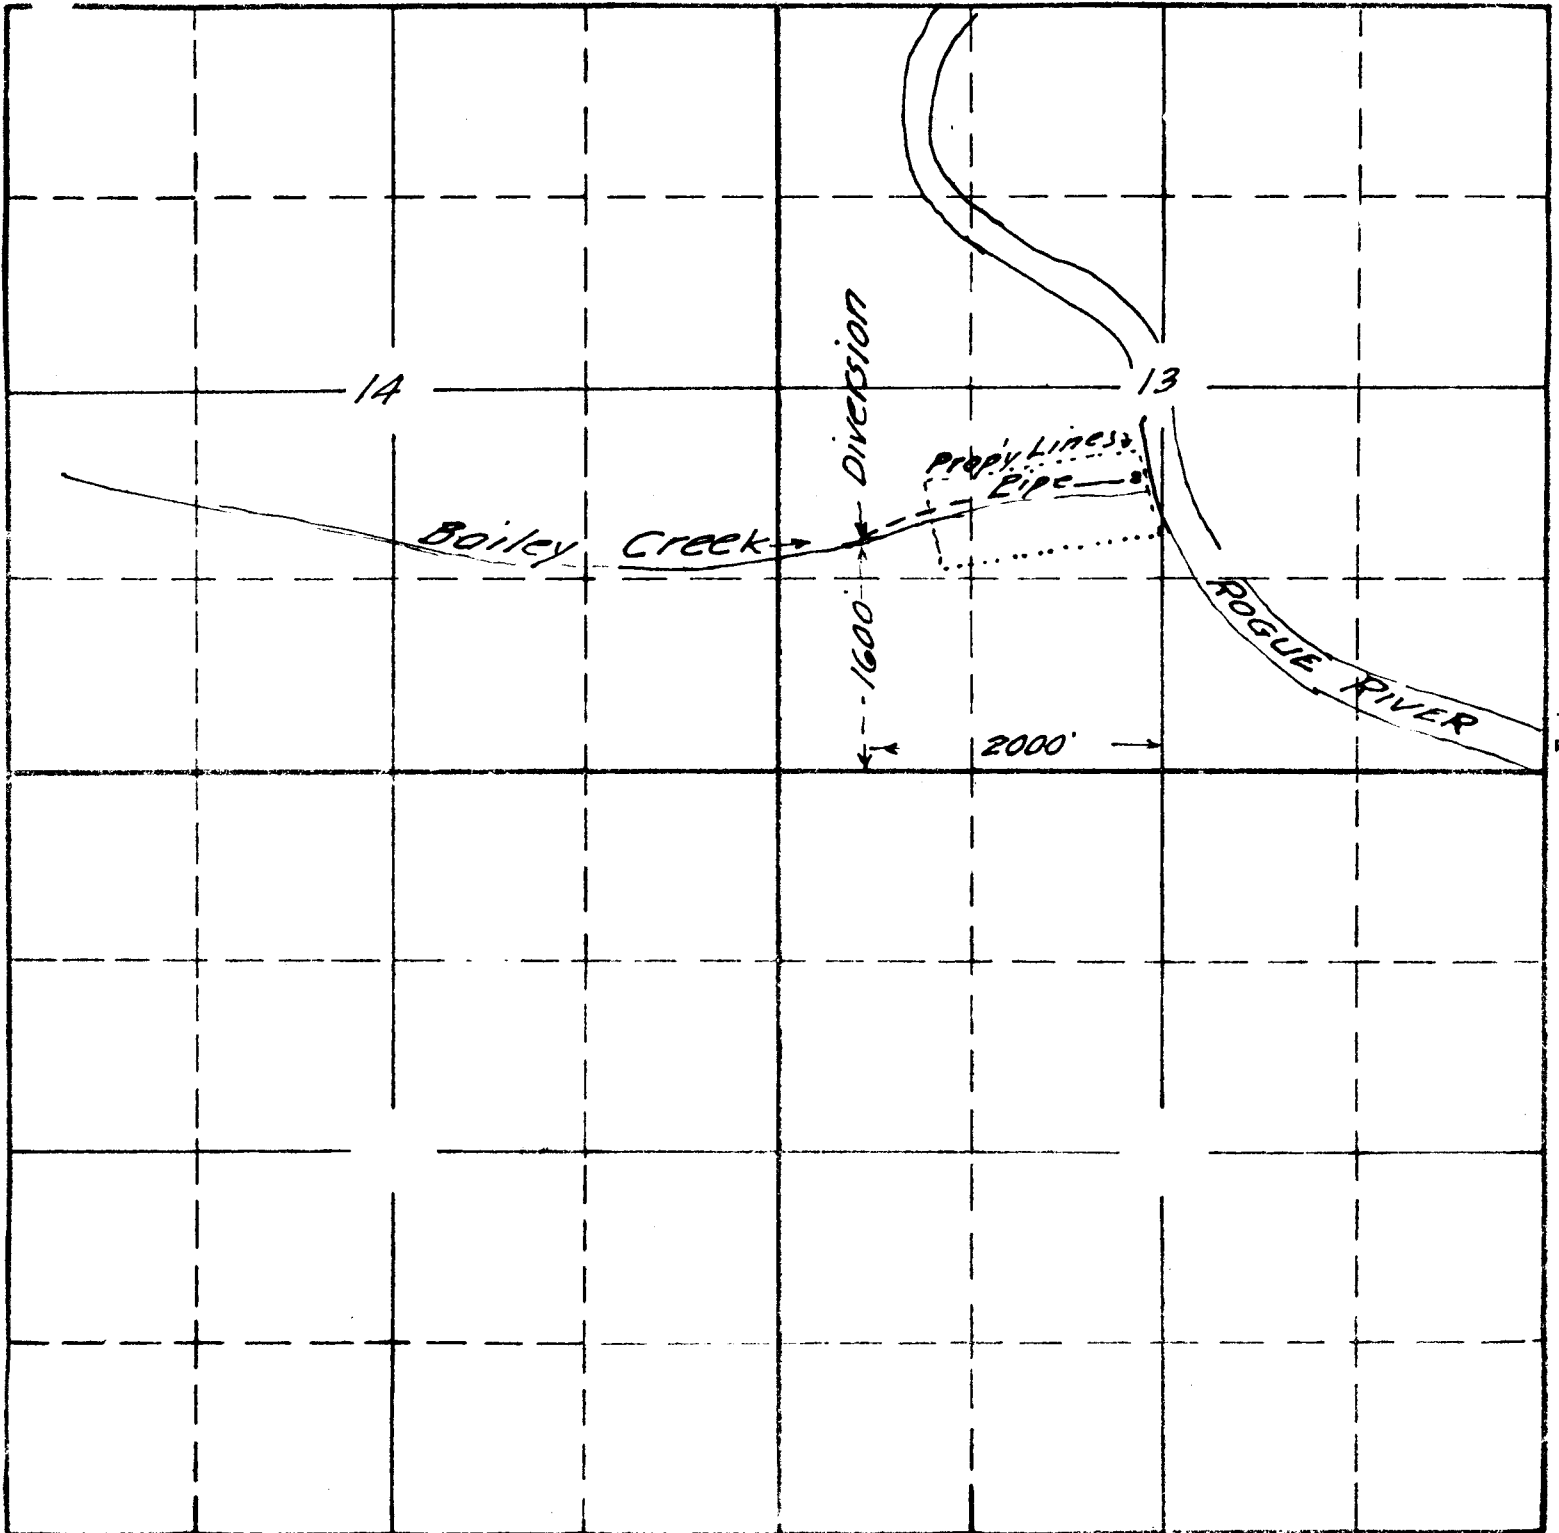

South

D. J. Yerian
July 1946

APPLICATION No. 21796
PERMIT No. 17149