


19

TOWNSHIP 39S, RANGE 3W, W. M.

North

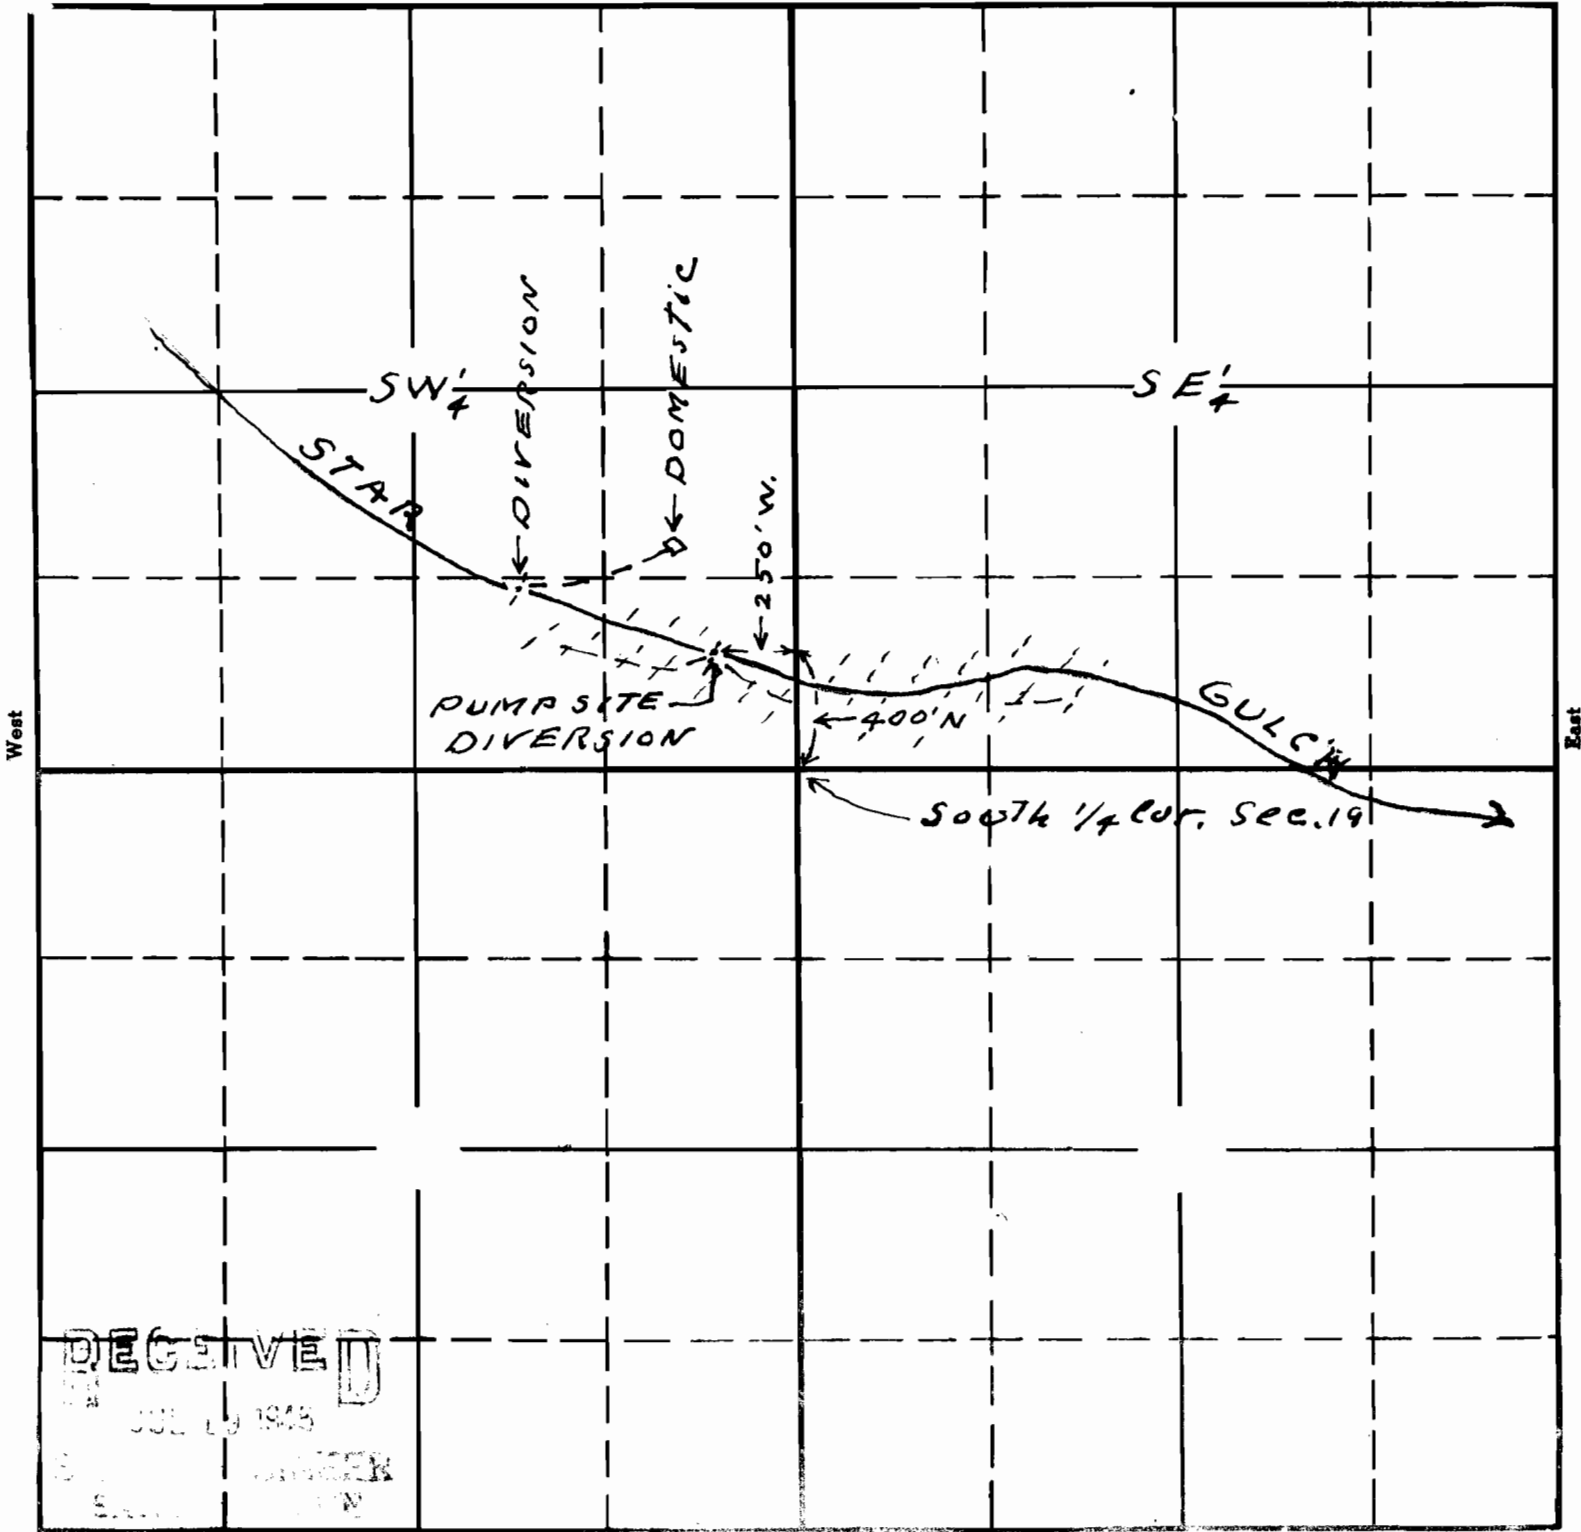

RECEIVED  
 JUL 19 1945  
 ENGINEER  
 DIVISION

South

21814

15-16C

Application map to accompany  
 papers of Frank F Beekman  
 for use of waters from Star  
 Gulch for domestic & mining

APPLICATION No. 21814  
 PERMIT No. 17163

This office 7/17/46 *Stambaugh*