


North

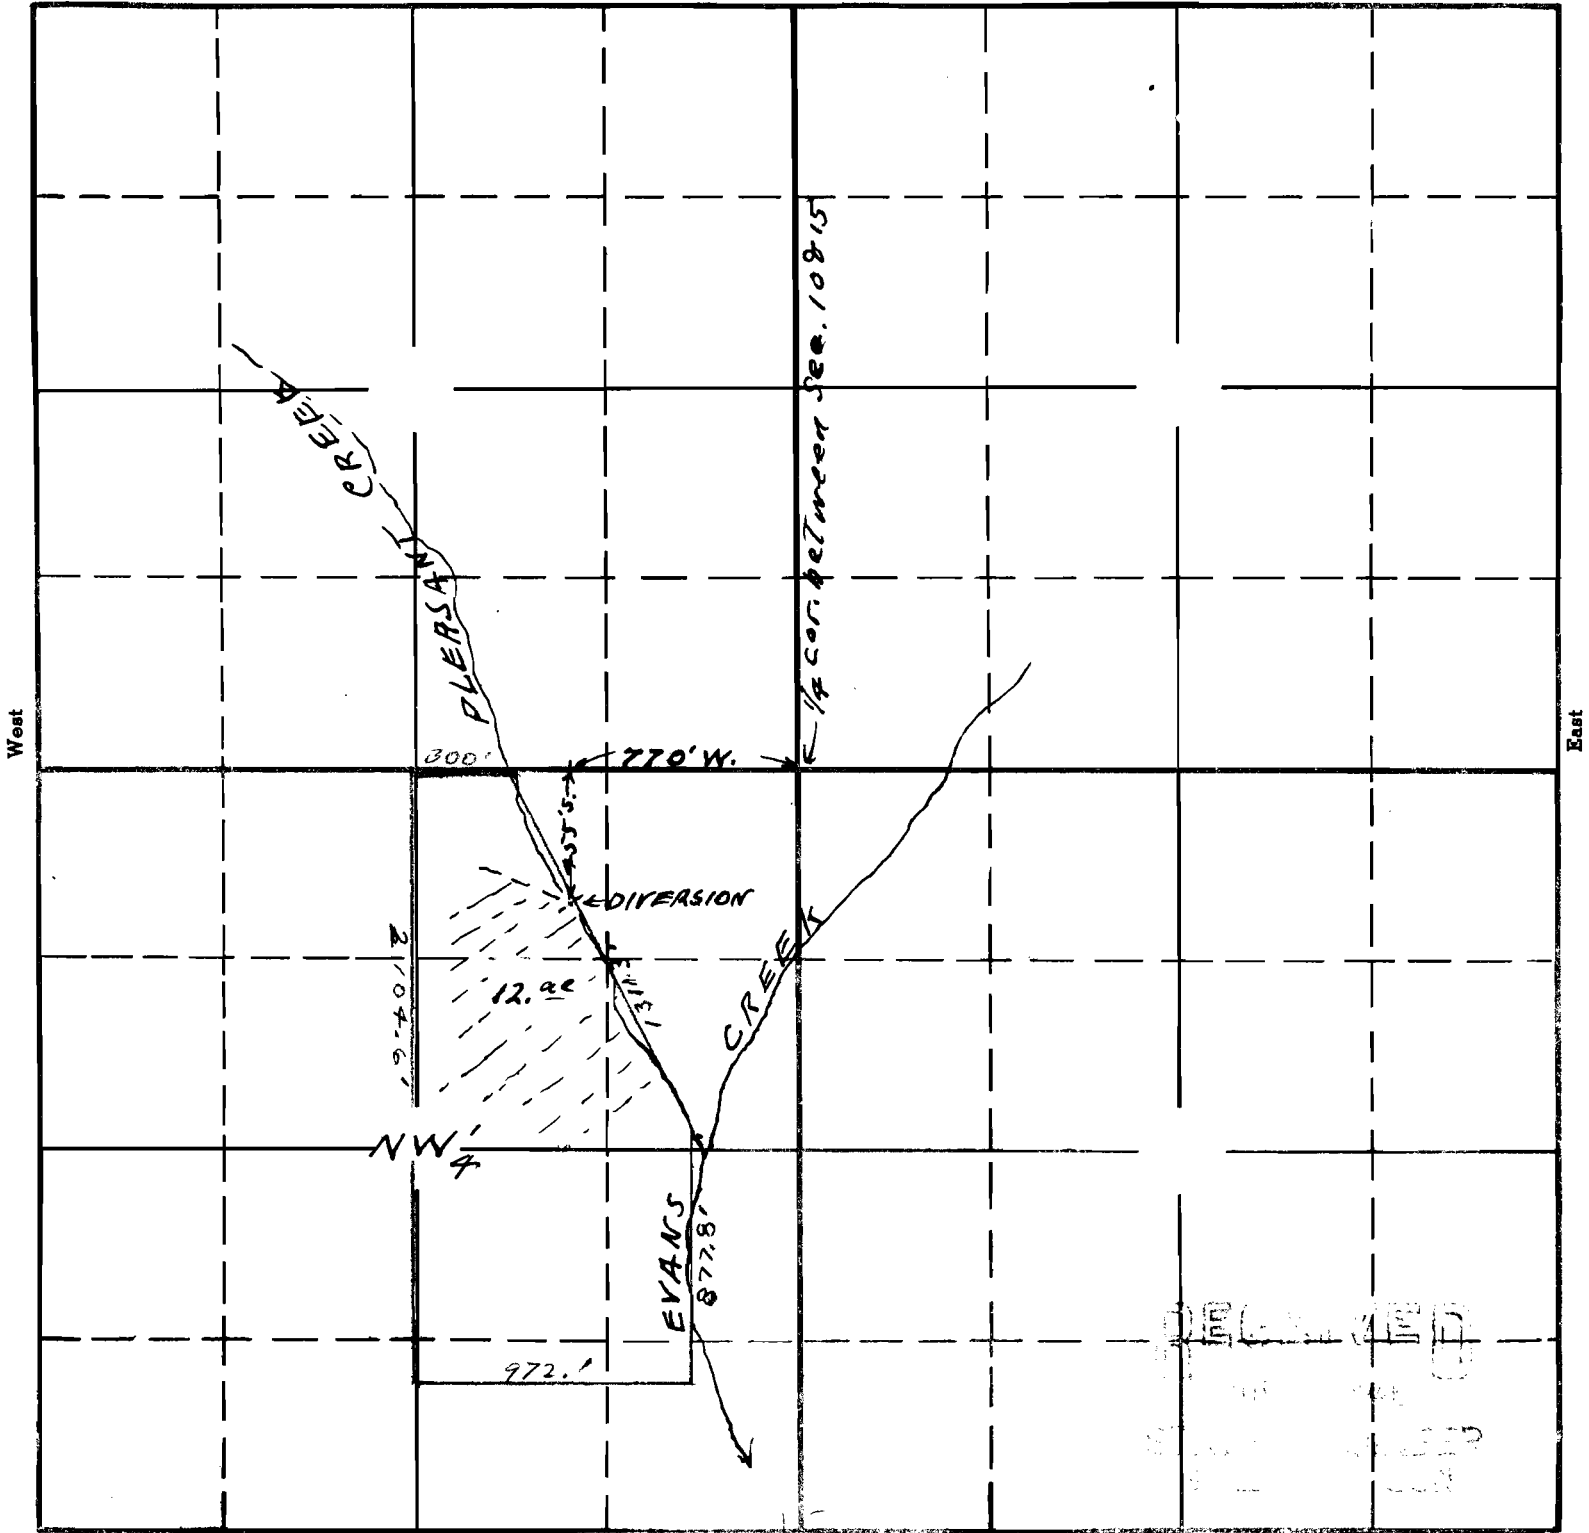

RECORDED  
 1946  
 17177

Map to accompany application of  
 F. S. Ballard for use of waters from  
 Pleasant Creek for irrigation.

APPLICATION No. 21839  
 PERMIT No. 17177

This office 7/27/46 *[Signature]*

17177