


SECTION 36

TOWNSHIP 13 S, RANGE 10 W, W. M.

North

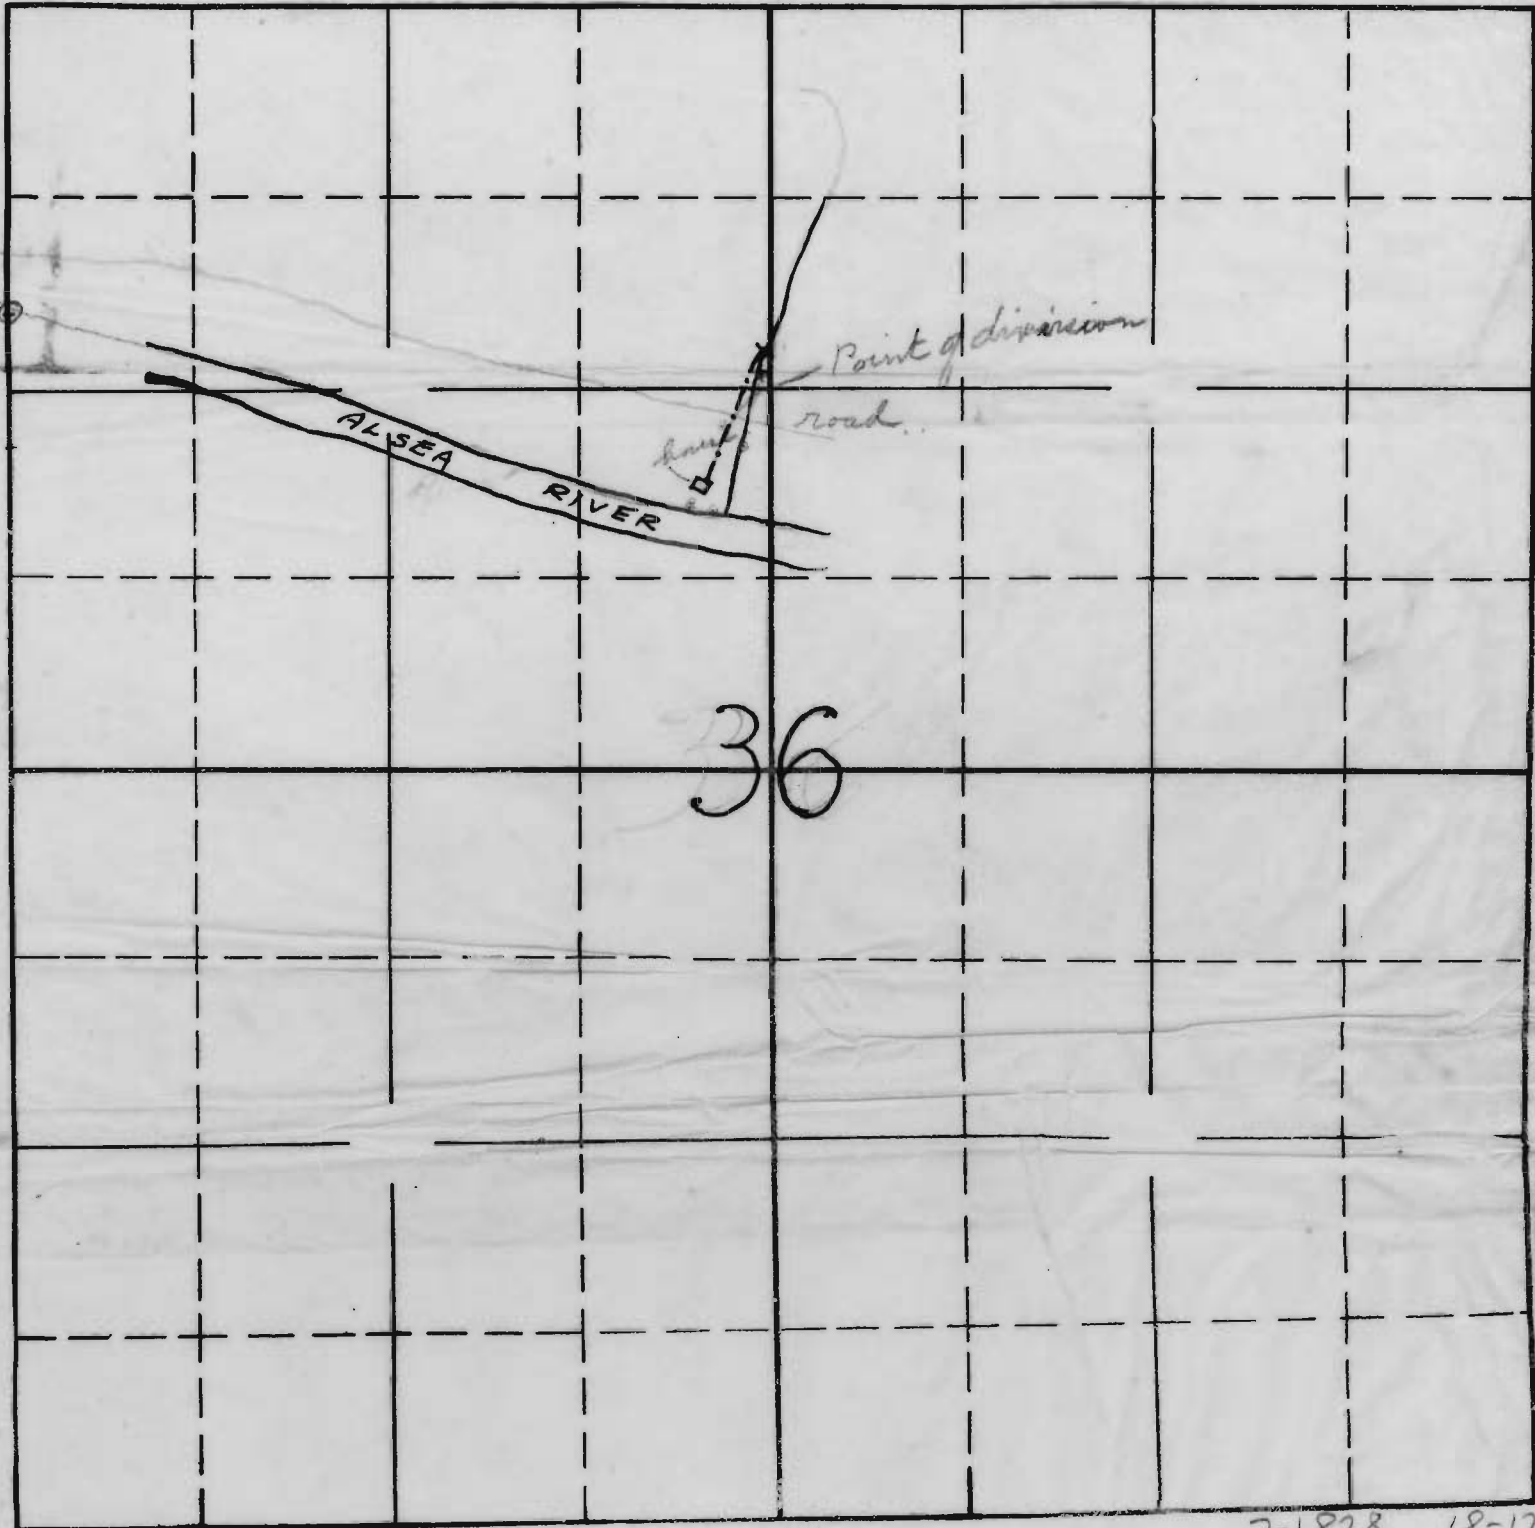

36

South

21828 18-12

APPLICATION No. 21828
PERMIT No. 17224