


10  
T.11S. R. 26 E. W.M.

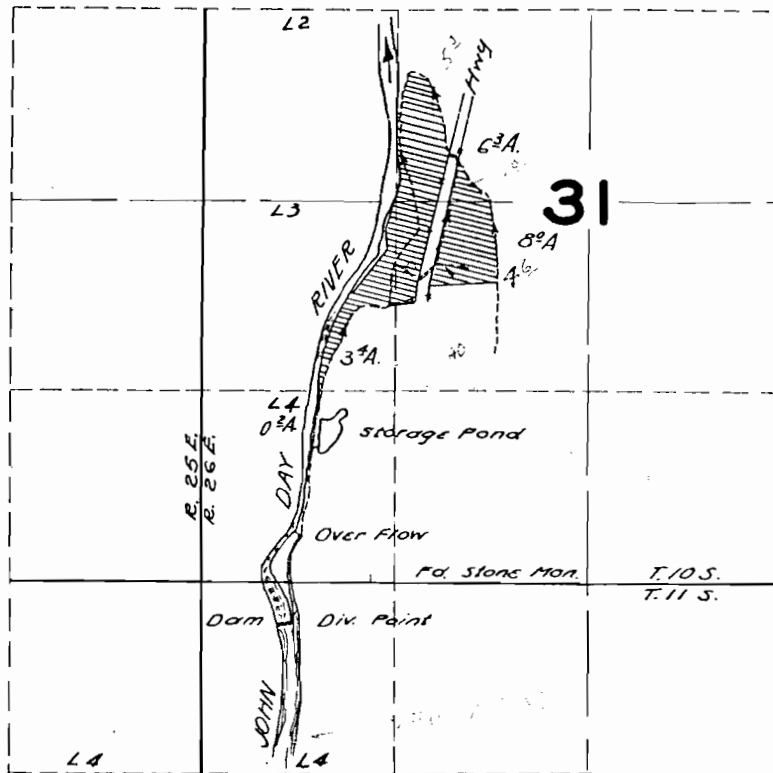

FINAL PROOF SURVEY

UNDER

Application No. 21848.. Permit No. 17226

IN NAME OF

.....W.J.FOREE.....

Surveyed OCT. 30. 1949., by H.L. COFFMAN..