


SECTION

TOWNSHIP 35 S, RANGE 6 W, W. M.

North

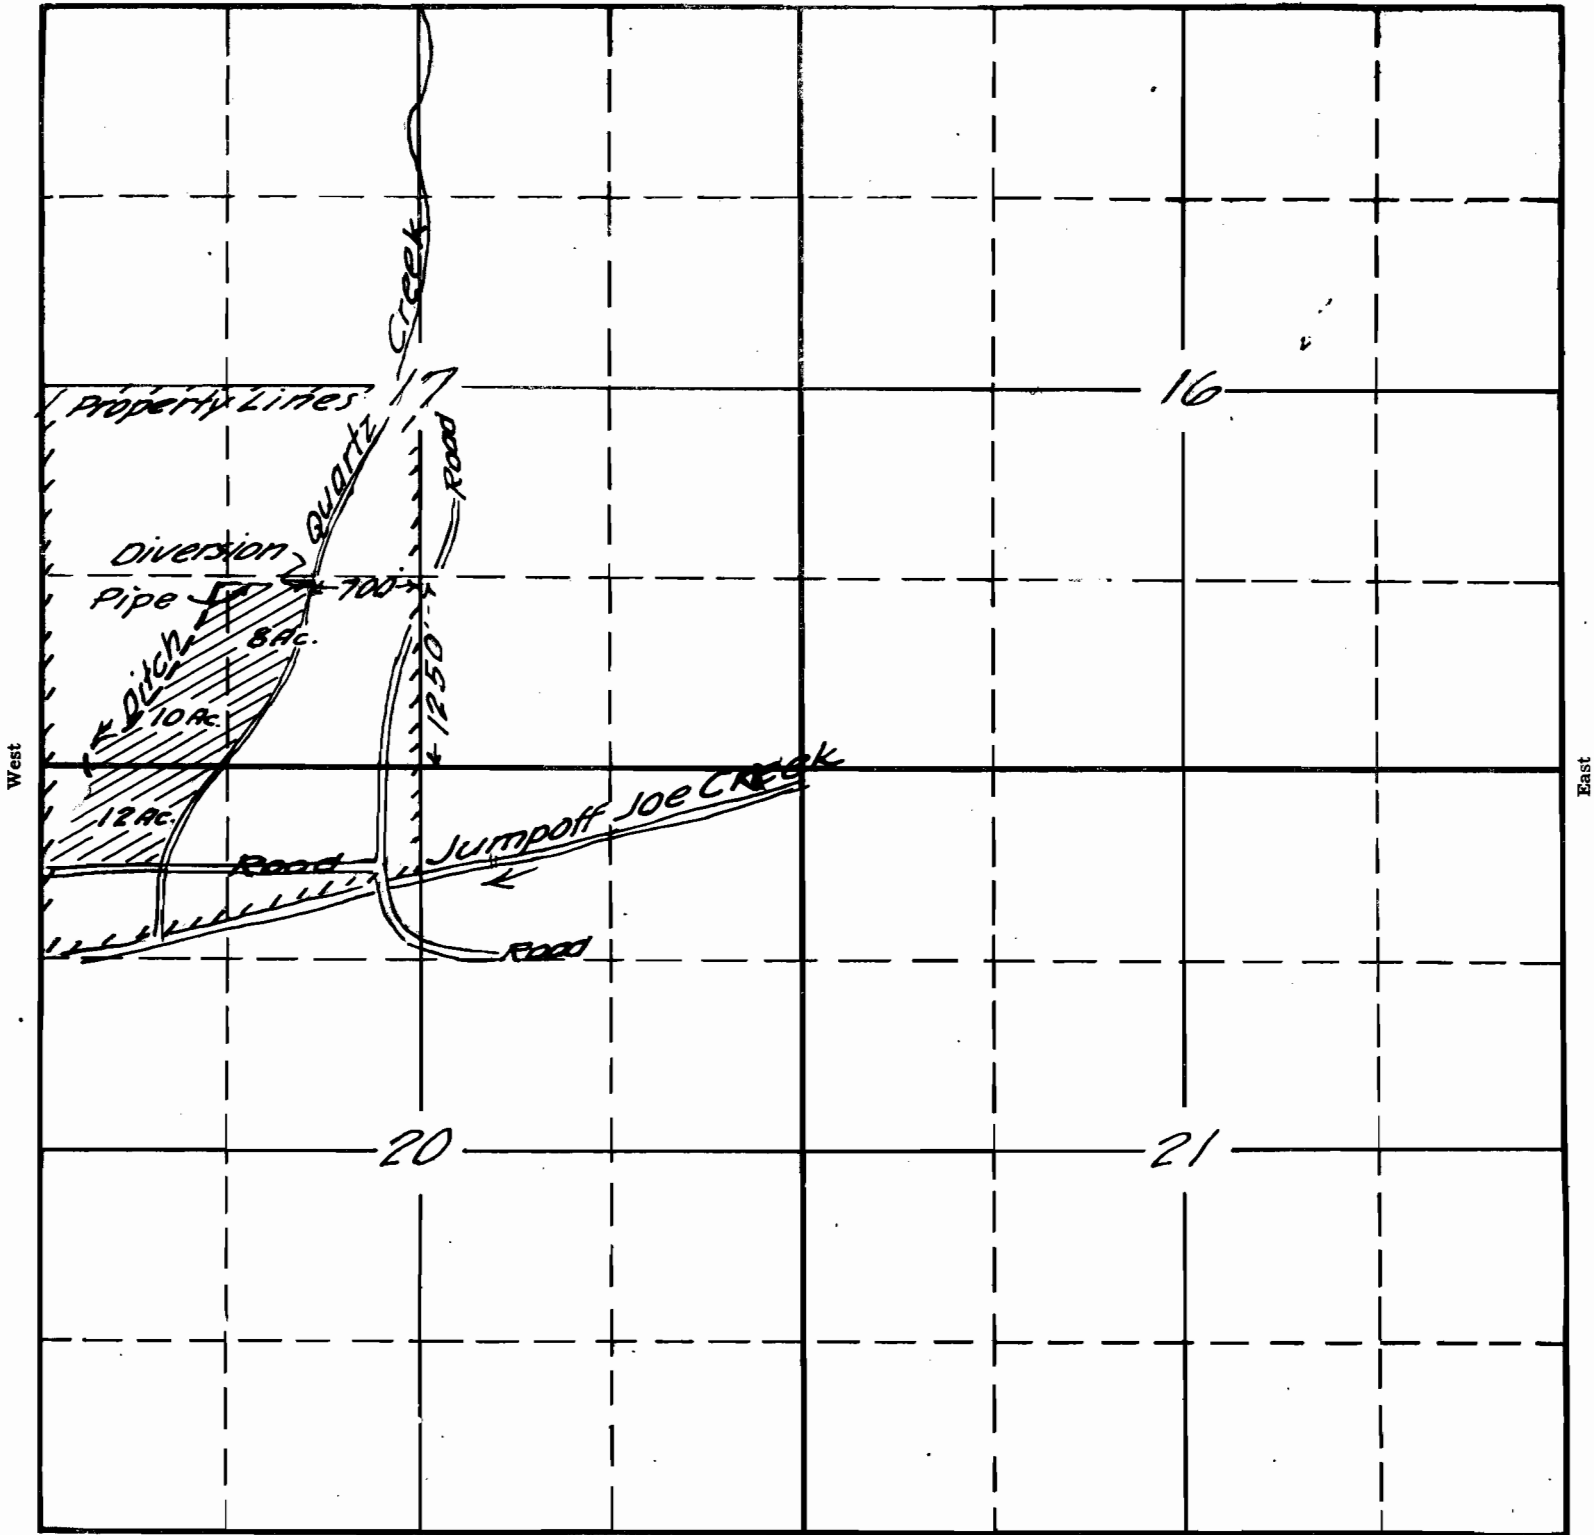


West

East

South

21913

15-78E

 

Charlie McNeill  
 Aug. 1946

APPLICATION No. 21913  
 PERMIT No. 17252