


18

TOWNSHIP 38S, RANGE 4W, W. M.

North

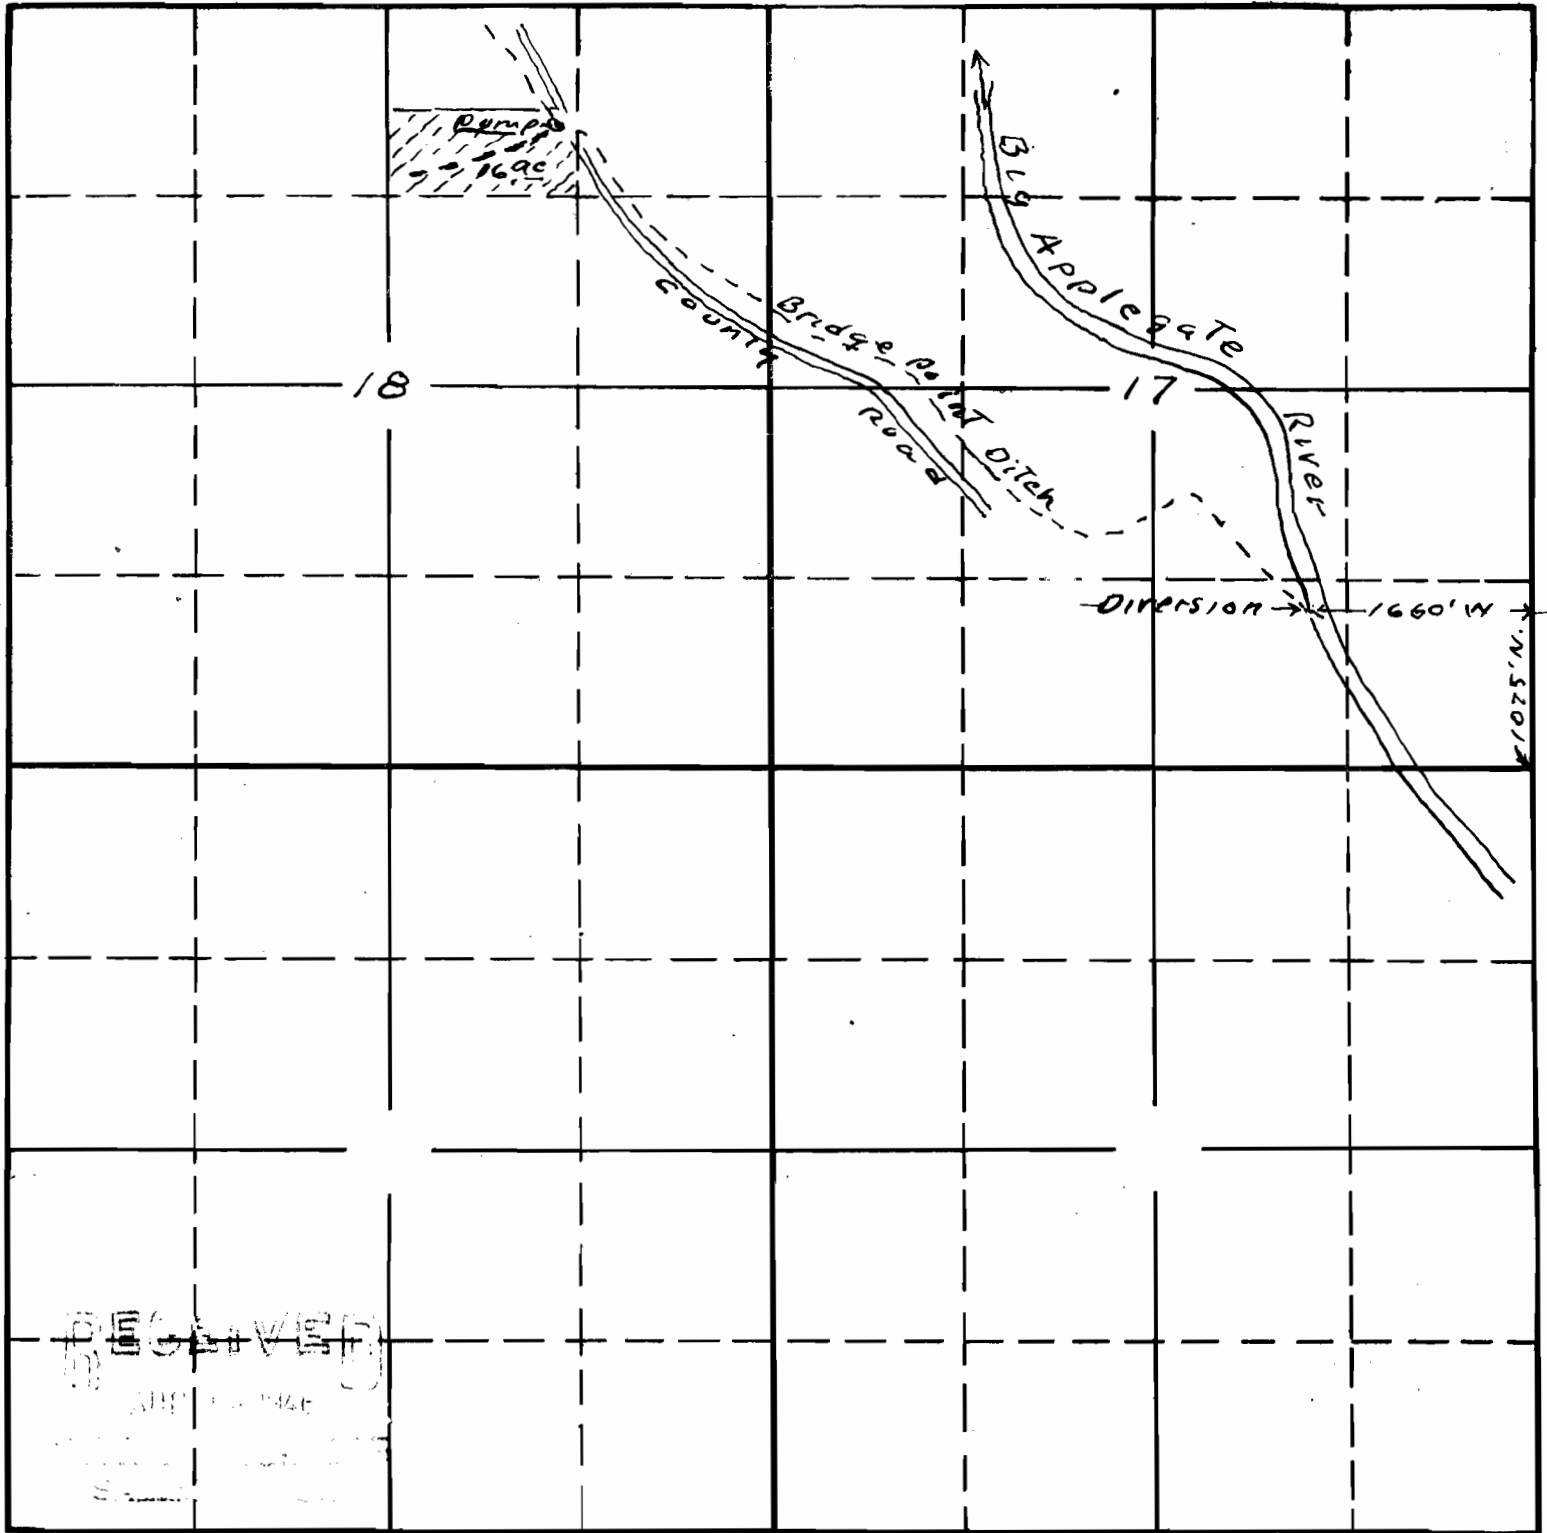

West

East

South

21925

15-8A

Map to accompany application of Virian I Whitsett for use of waters of Big Applegate River for irrigation

APPLICATION No. 21925

PERMIT No. 17258

This office 7/27/46 *[Signature]*