


SECTION

28

TOWNSHIP 35 S, RANGE 7 W, W. M.

North

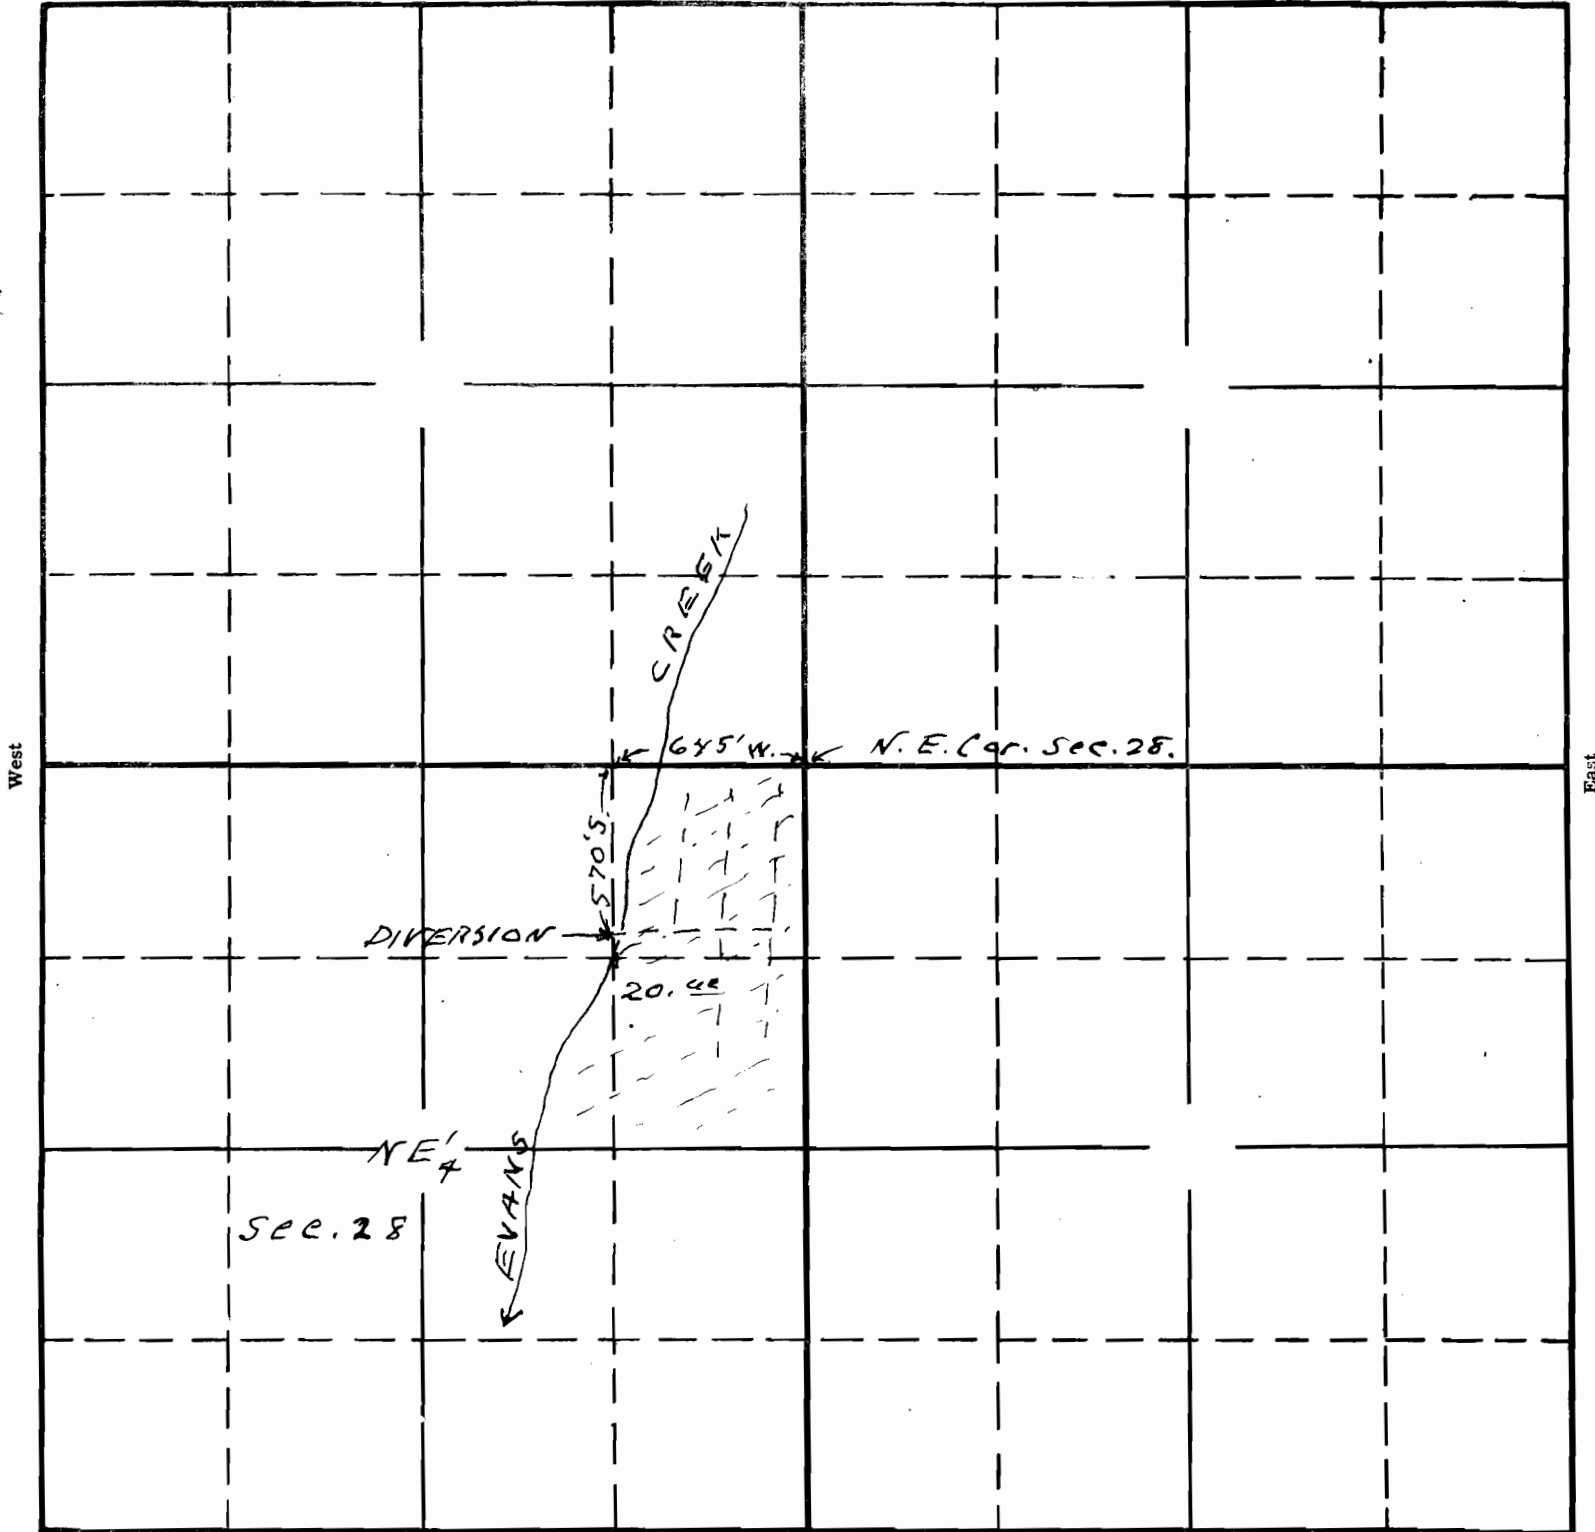

South

Map to accompany application of C.W. Jensen for use of waters from Evans Creek for irrigation purposes

22034 1507
APPLICATION No. 22034
PERMIT No. 17310

This office 10/8/46 *Smith*