


Walter J. Young P. 17320  
Application No. 21960  
Permit No. 17320  
Priority - Sept. 13, 1946  
Find in ~~Bear Creek Misc.~~, Vol. 5  
LARSON

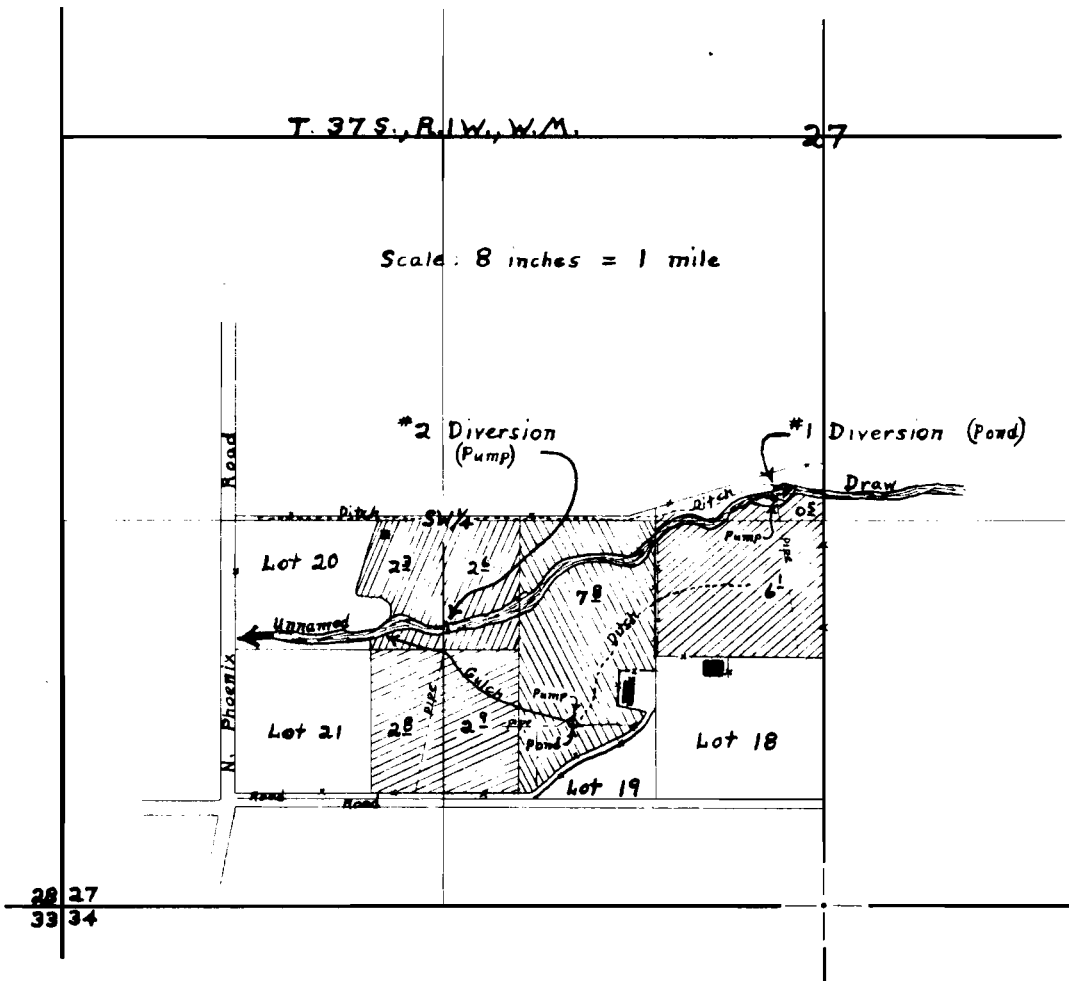

**FINAL PROOF SURVEY**  
UNDER

Application No. **21960** Permit No. **17320** **CERT. 23421**  
IN NAME OF

**Walter J. Young**

Surveyed **Jan. 31 1957** by **D. C. Hendrix, W.M.**