


T 37 S., R 8 W., W. M.
Scale 400' = 1" Oct. 1946

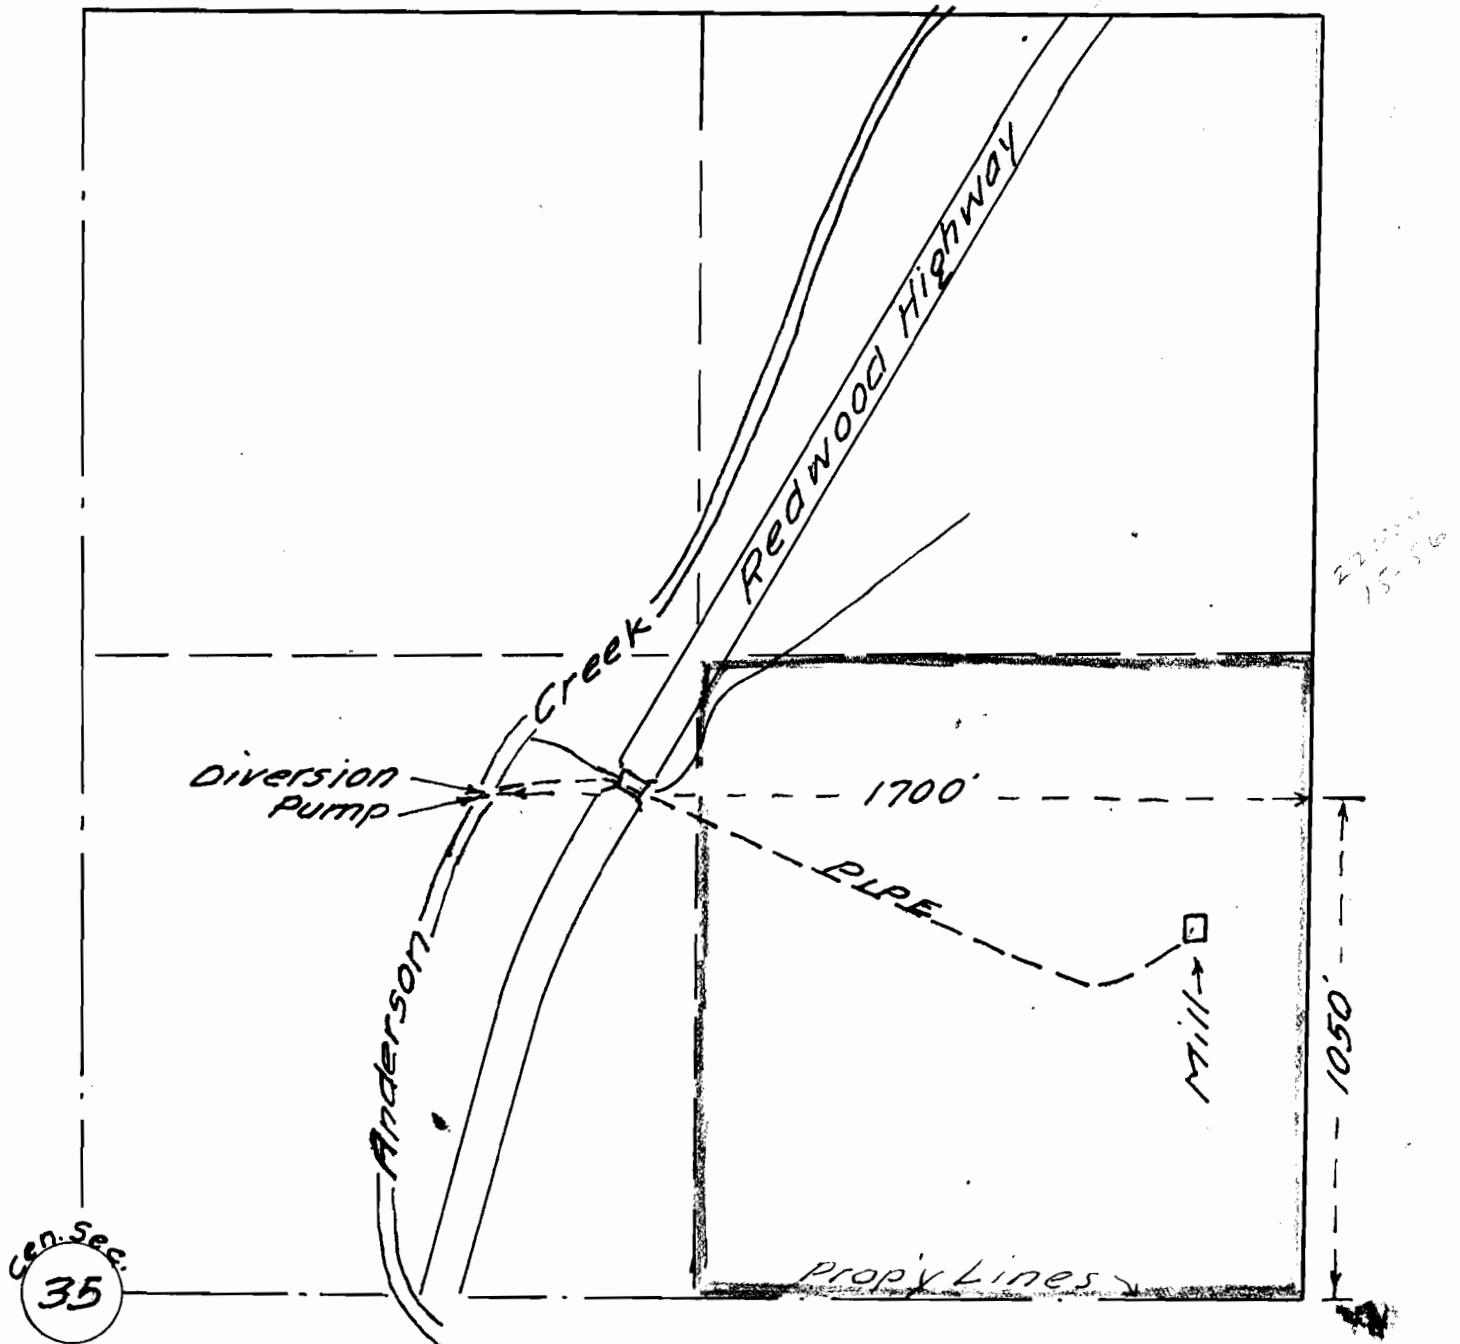

S. H. & W. Lumber Co.
by O. L. Hogan

Application No. 22055 22055
Permit No 17322