


33

TOWNSHIP 40 S, RANGE 3 W, W. M.

North

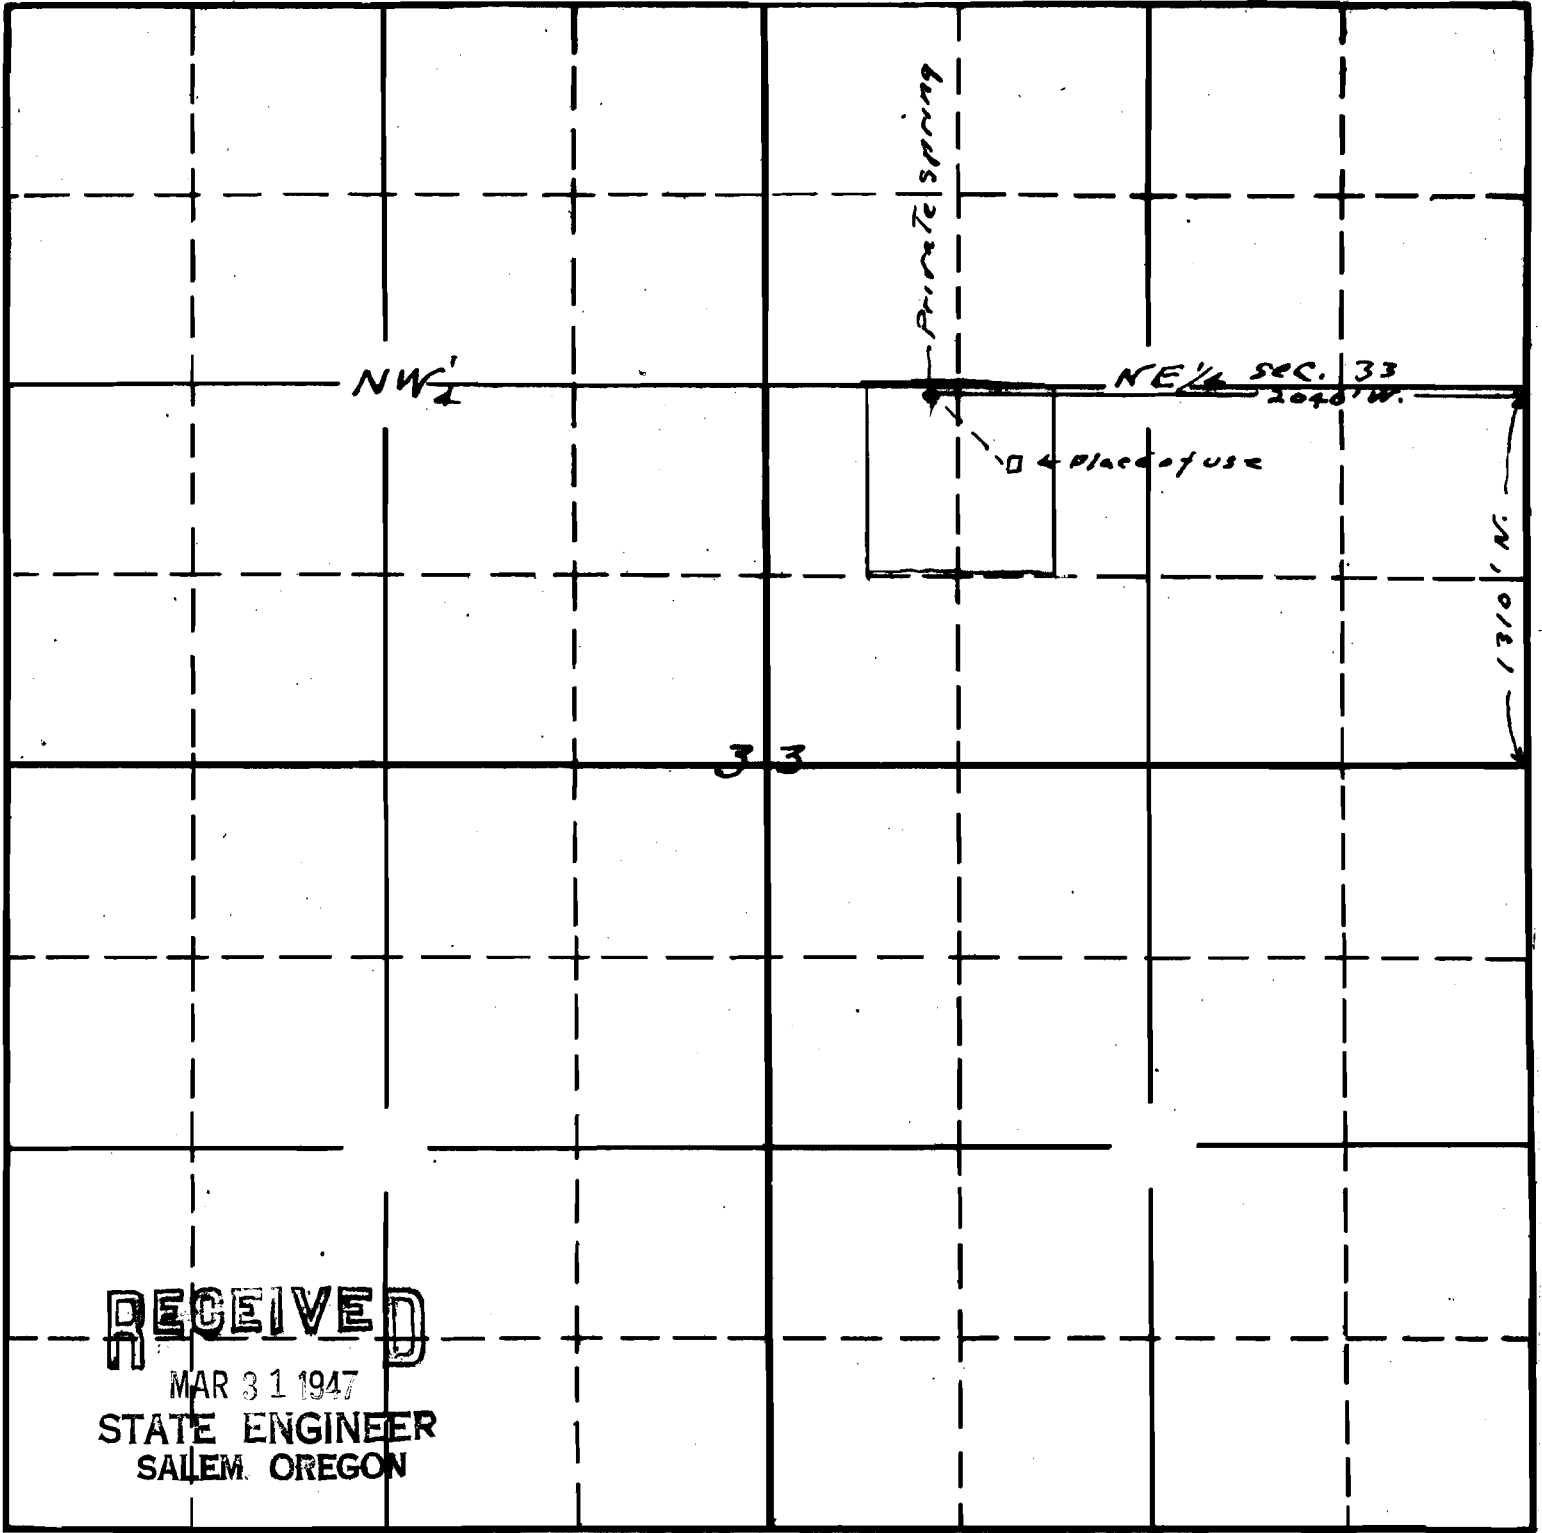

RECEIVED

MAR 31 1947

STATE ENGINEER
SALEM, OREGON

South

22385

15-16D

Map to accompany application of
J. C. Wagner for use of water from
spring on his place for domestic purposes

APPLICATION No. 22385
PERMIT No. 17646

This office 3/14/47 *Wagner*