


SECTION

29

TOWNSHIP 28 S , RANGE 14 W, W. M.

North

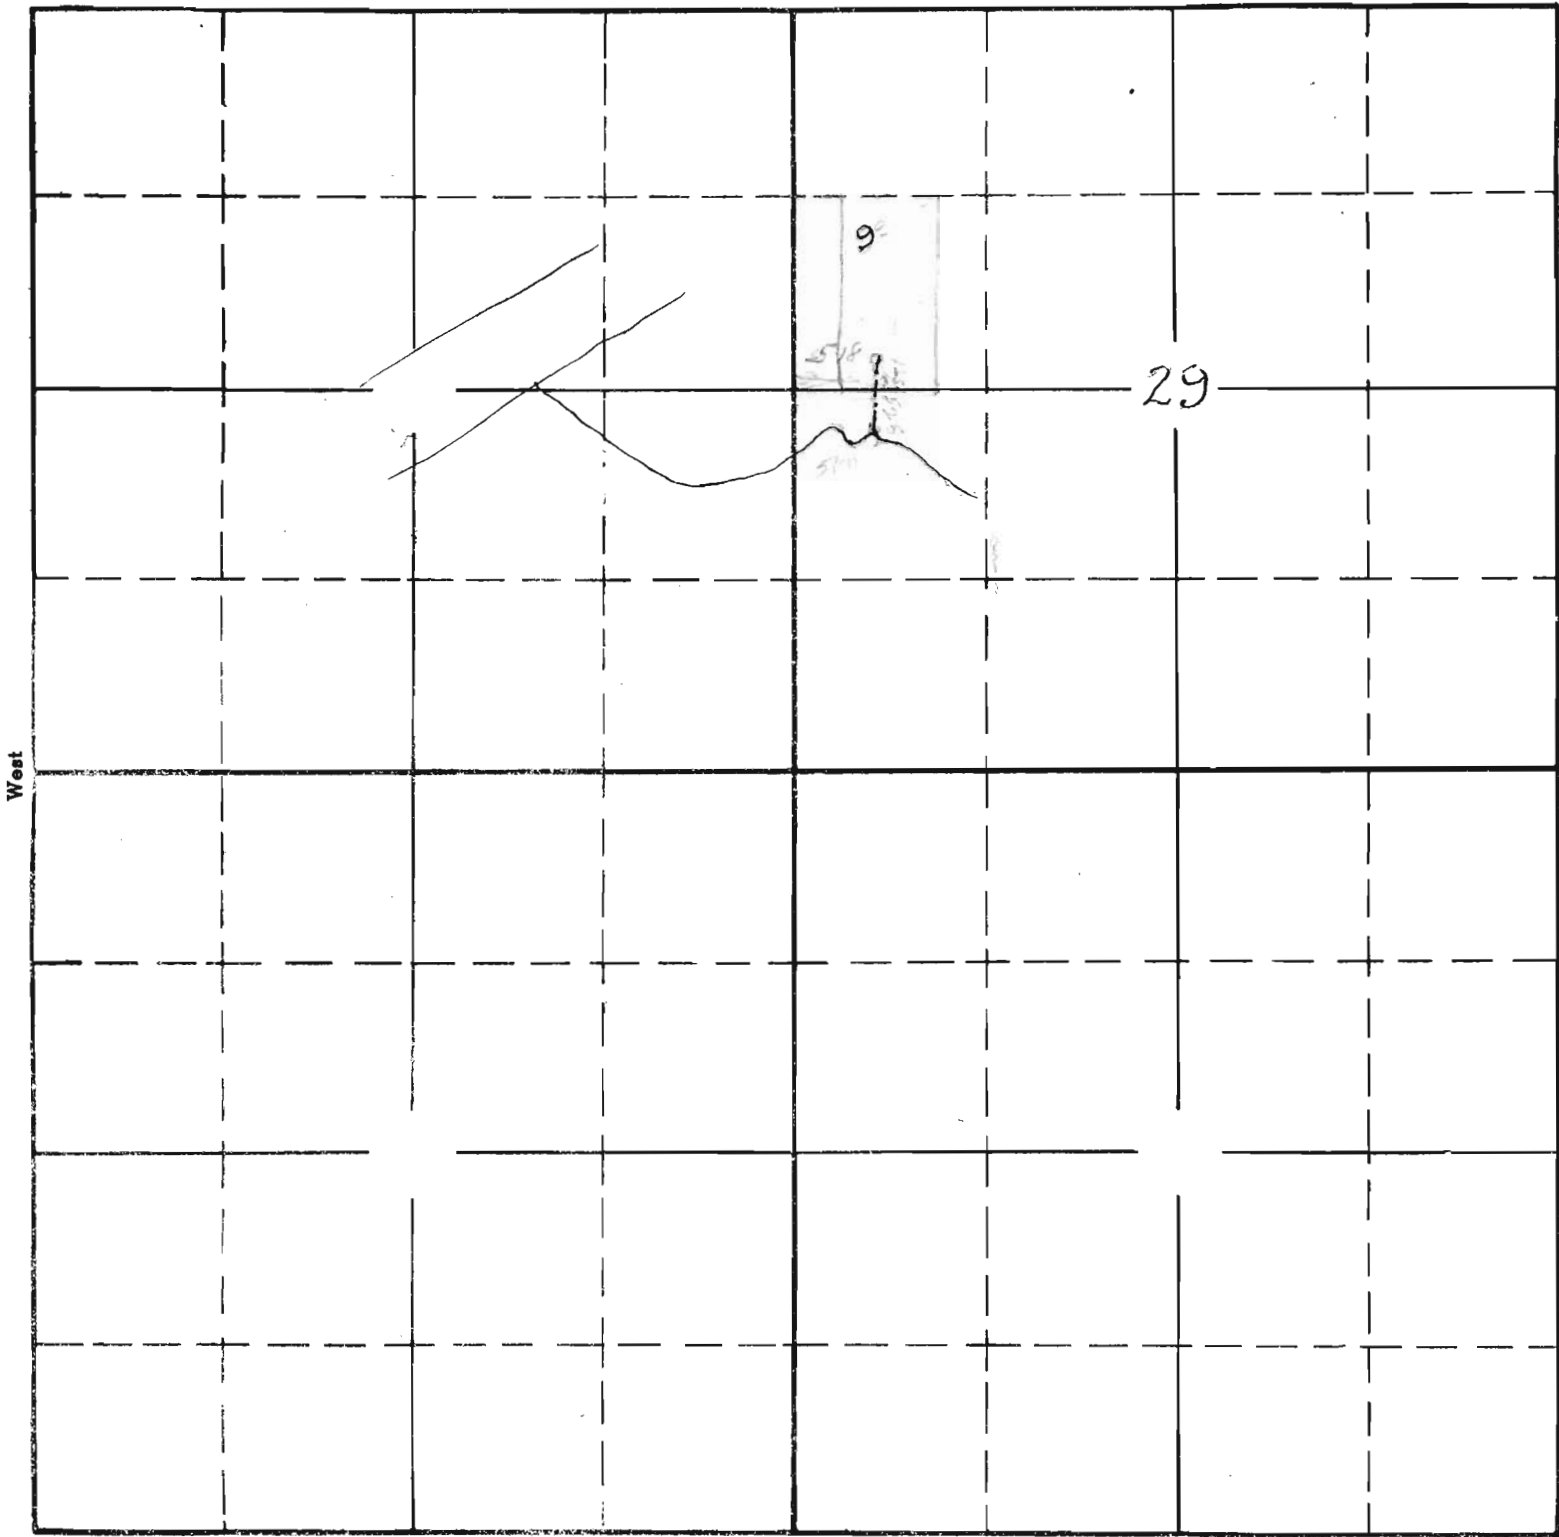

South

APPLICATION No. 21915  
PERMIT No. 17380