


SECTION

40

TOWNSHIP 38 S, RANGE 3 W, W. M.

North

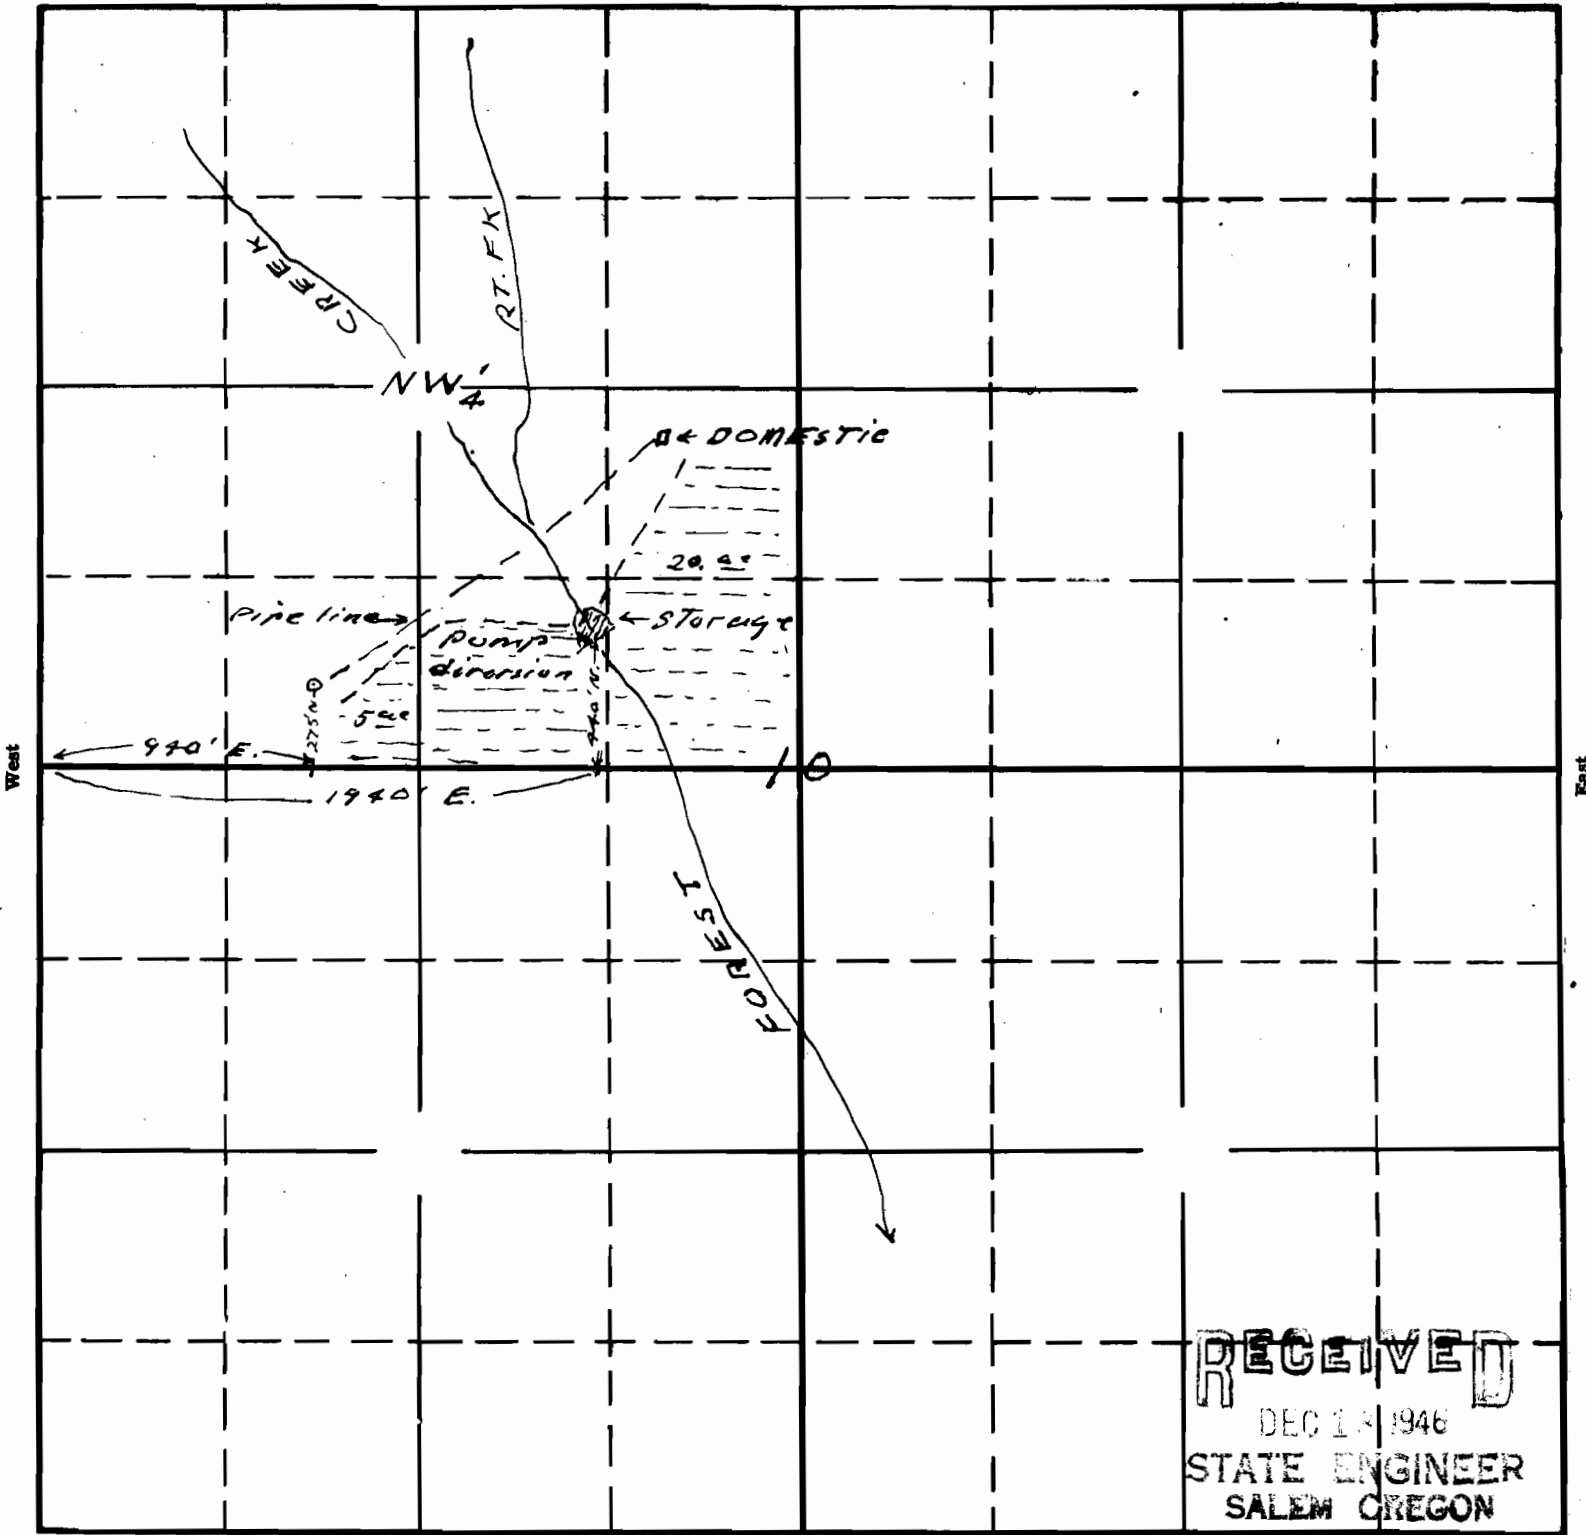

RECEIVED
 DEC 14 1946
 STATE ENGINEER
 SALEM OREGON

22144

15 16 5


South

Map to accompany application of
 Mrs Gertrude Winningham for use
 of waters from Forest Creek for irrigation
 and Winningham Sprg. for domestic.

APPLICATION No. 22144

PERMIT No. 17437

This office 12/16/46

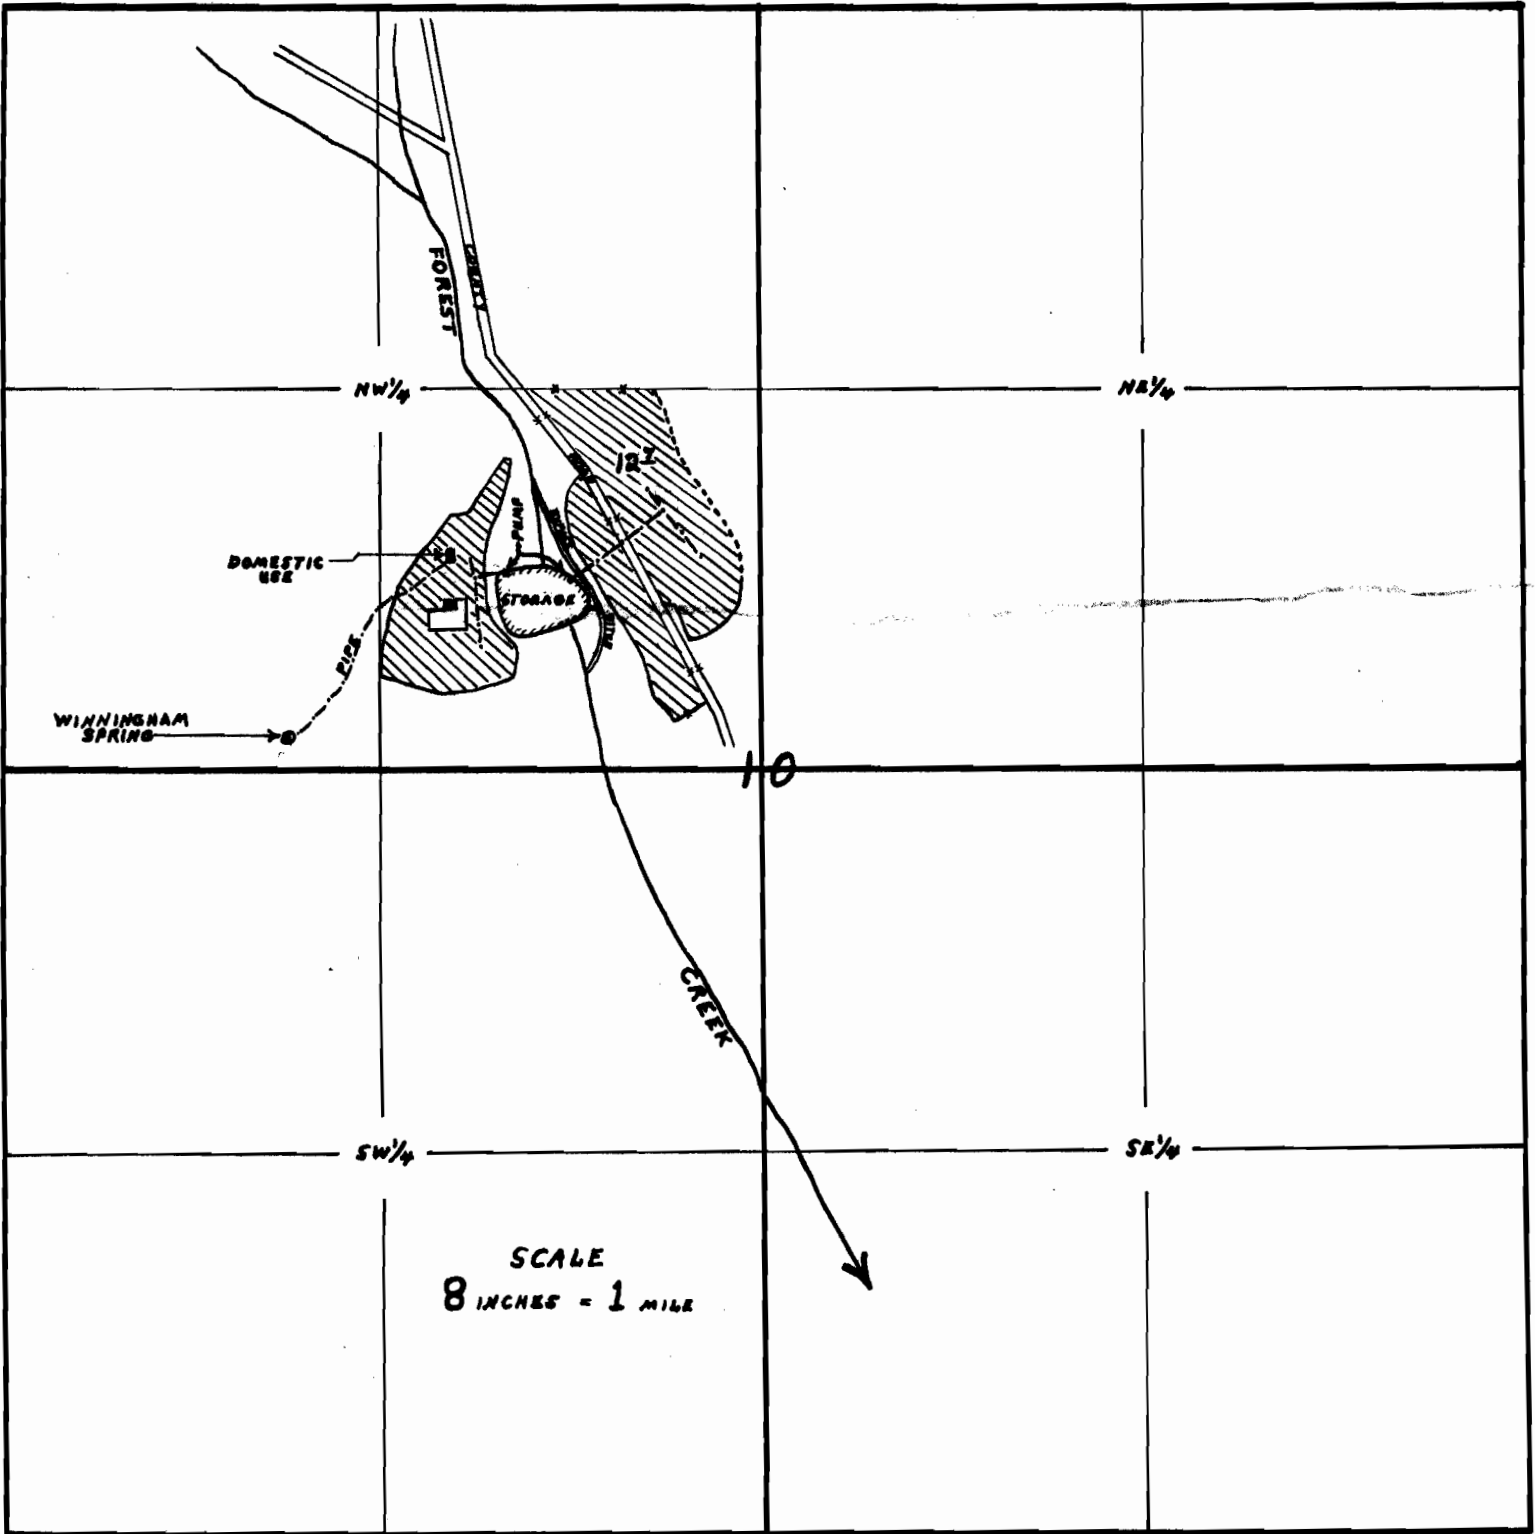

MAP ACCOMPANYING FINAL PROOF OF
MRS GERTRUDE WINNINGHAM, FOR USE OF WATER
FROM FOREST CREEK, WINNINGHAM SPRING AND
STORAGE FOR IRRIGATION AND DOMESTIC PURPOSES.

MAP COPIED FROM PLANE TABLE
SURVEY - MADE 11-17-54

David B. Hendrix
WATERMASTER DIST. NO. 15

RECEIVED
DEC 2 1954
STATE ENGINEER
SALEM, OREGON

APPLICATION No. R-22143
22144
PERMIT No. 17437
R-859