


T.34S, R.8W, W.1
Scale 8"=1 Mile

Permit: S 17498
Volume: 4A
Strm: N FK ROCKY G
Trib: ROCKY G
Priority: 2/06/47

Permit: S 17498
Volume: 4A
Strm: S FK ROCKY G
Trib: ROCKY G
Priority: 2/06/47

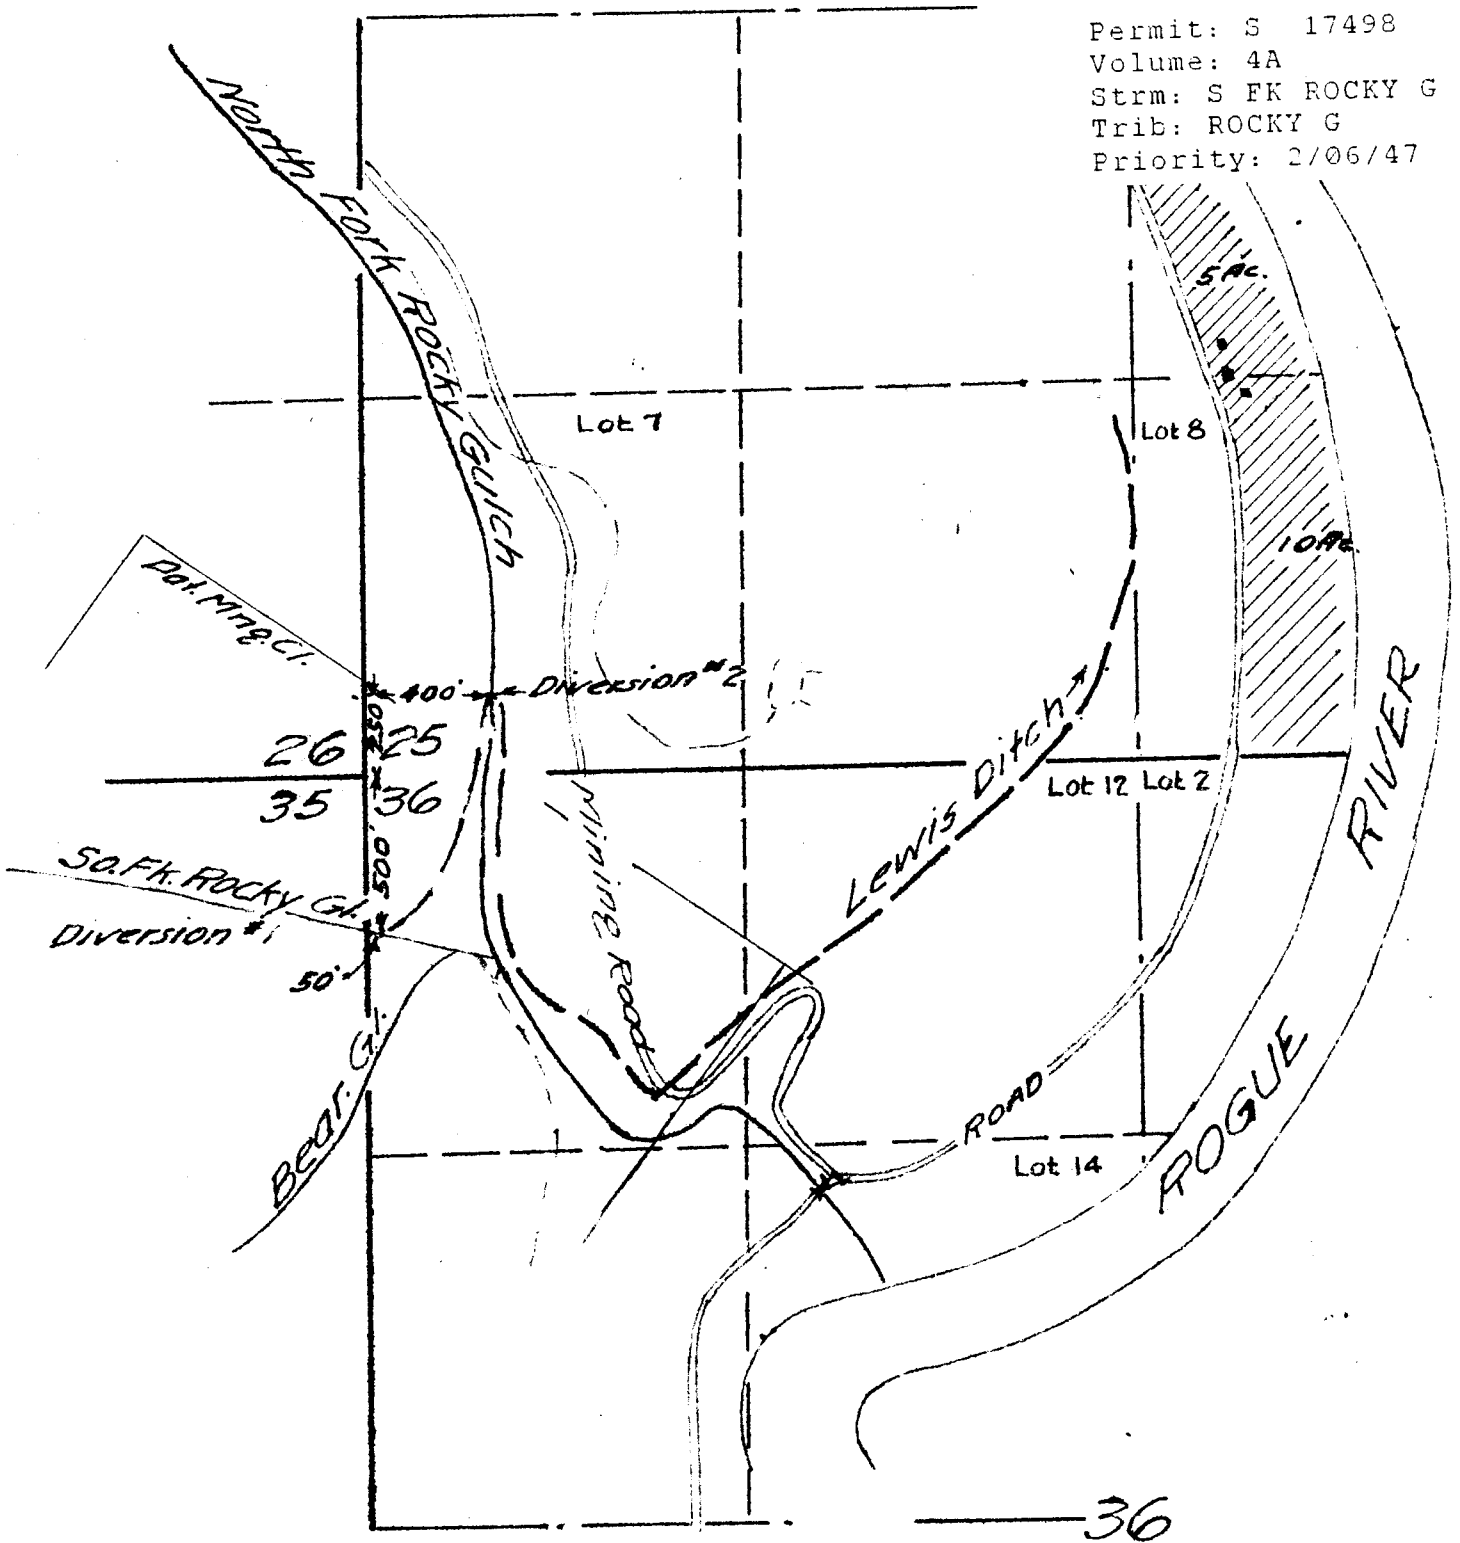

Estella M. Lewis

Application No. 22225
Permit No. 17394