


SECTION

Permit: S 17506
Volume: 4A
Strm: DUTCHER CR
Trib: LIMPY CR
Priority: 2/11/47

TOWNSHIP 36 S., RANGE 7 W.

North

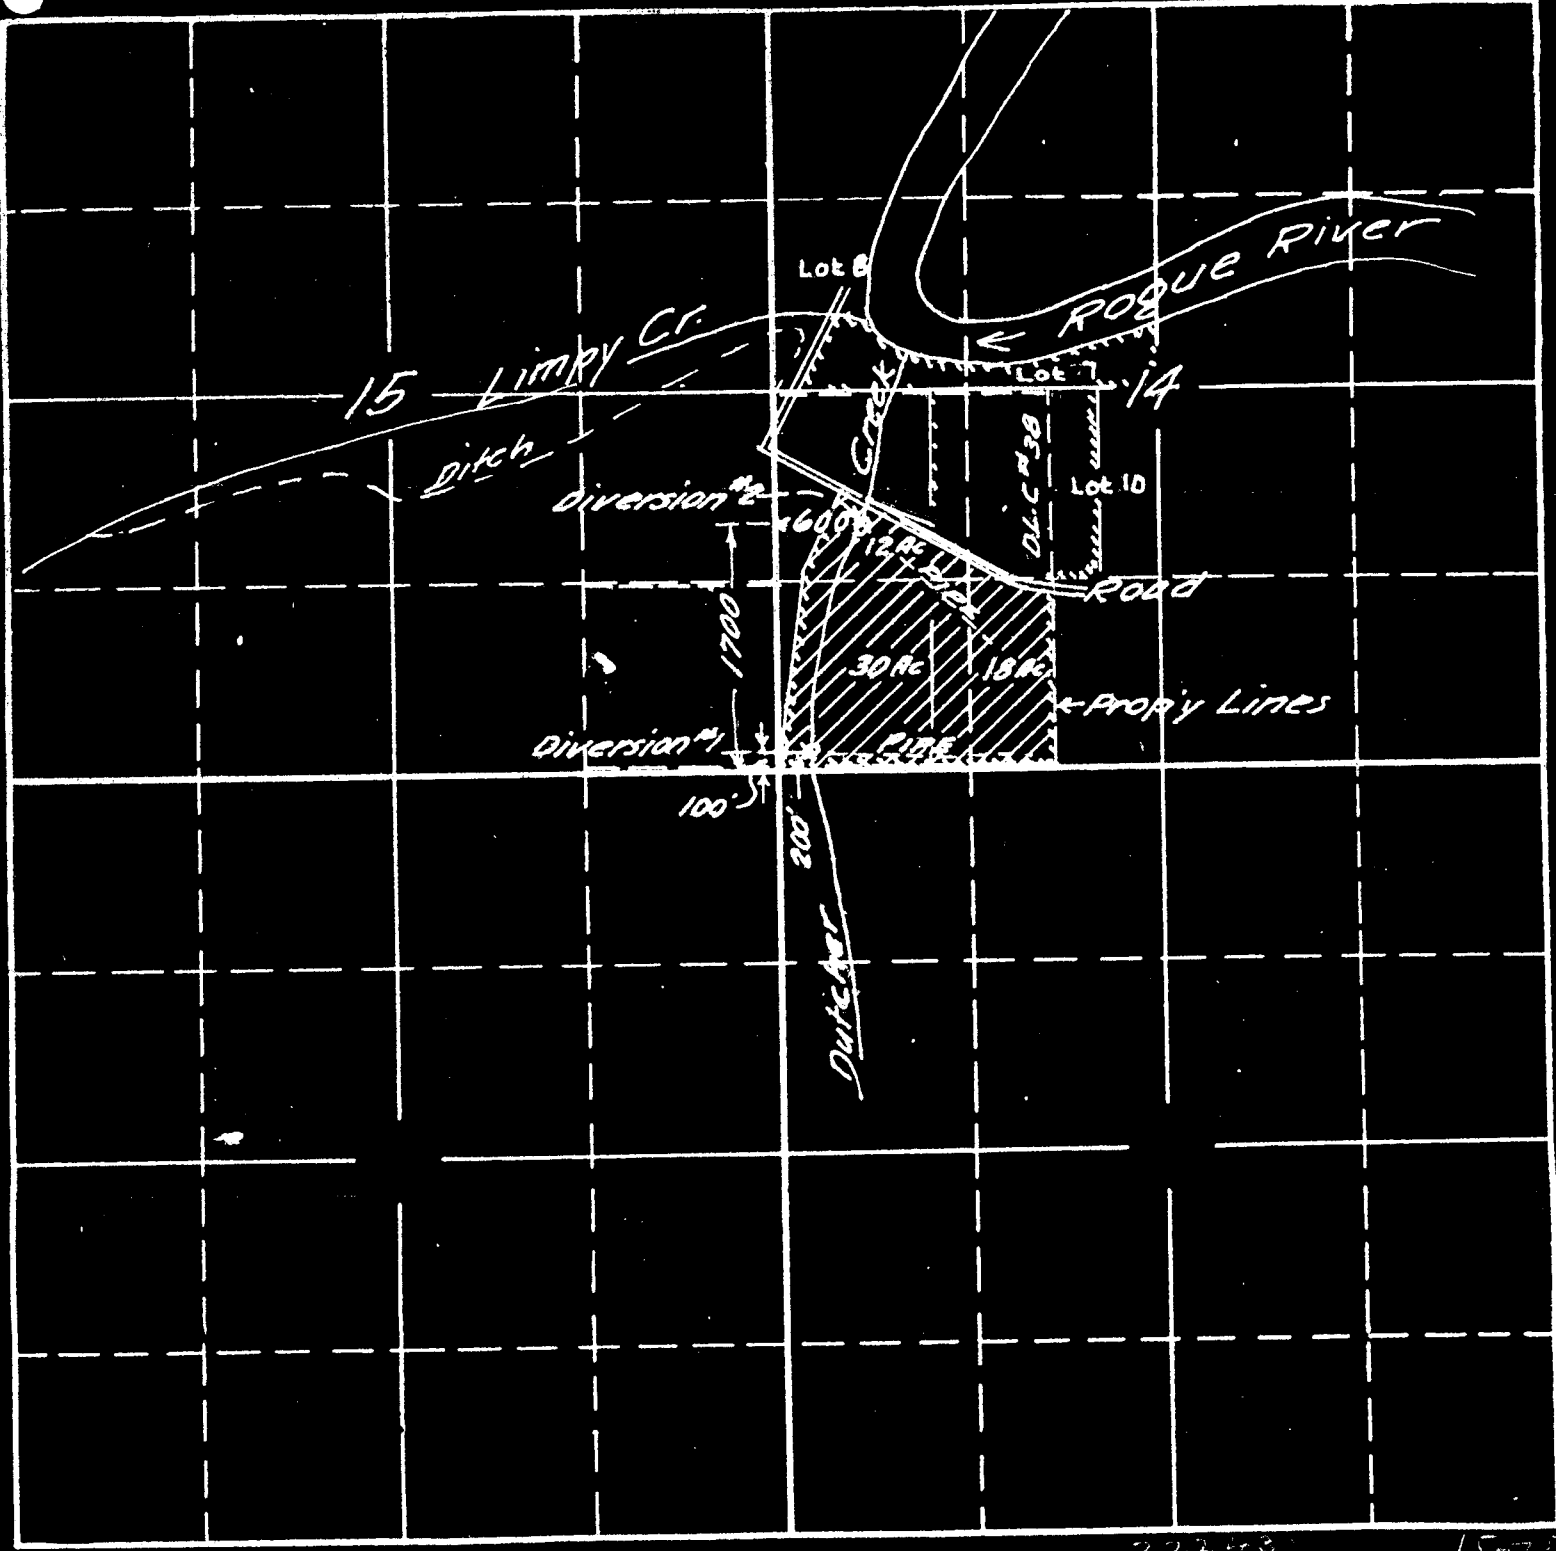

South

David Tonelli
Feb. 1947

22243 15-73F
APPLICATION No. 22243
PERMIT No. 17506