


SECTION

14, 15, 16

TOWNSHIP 25, RANGE 5 W, W. M.

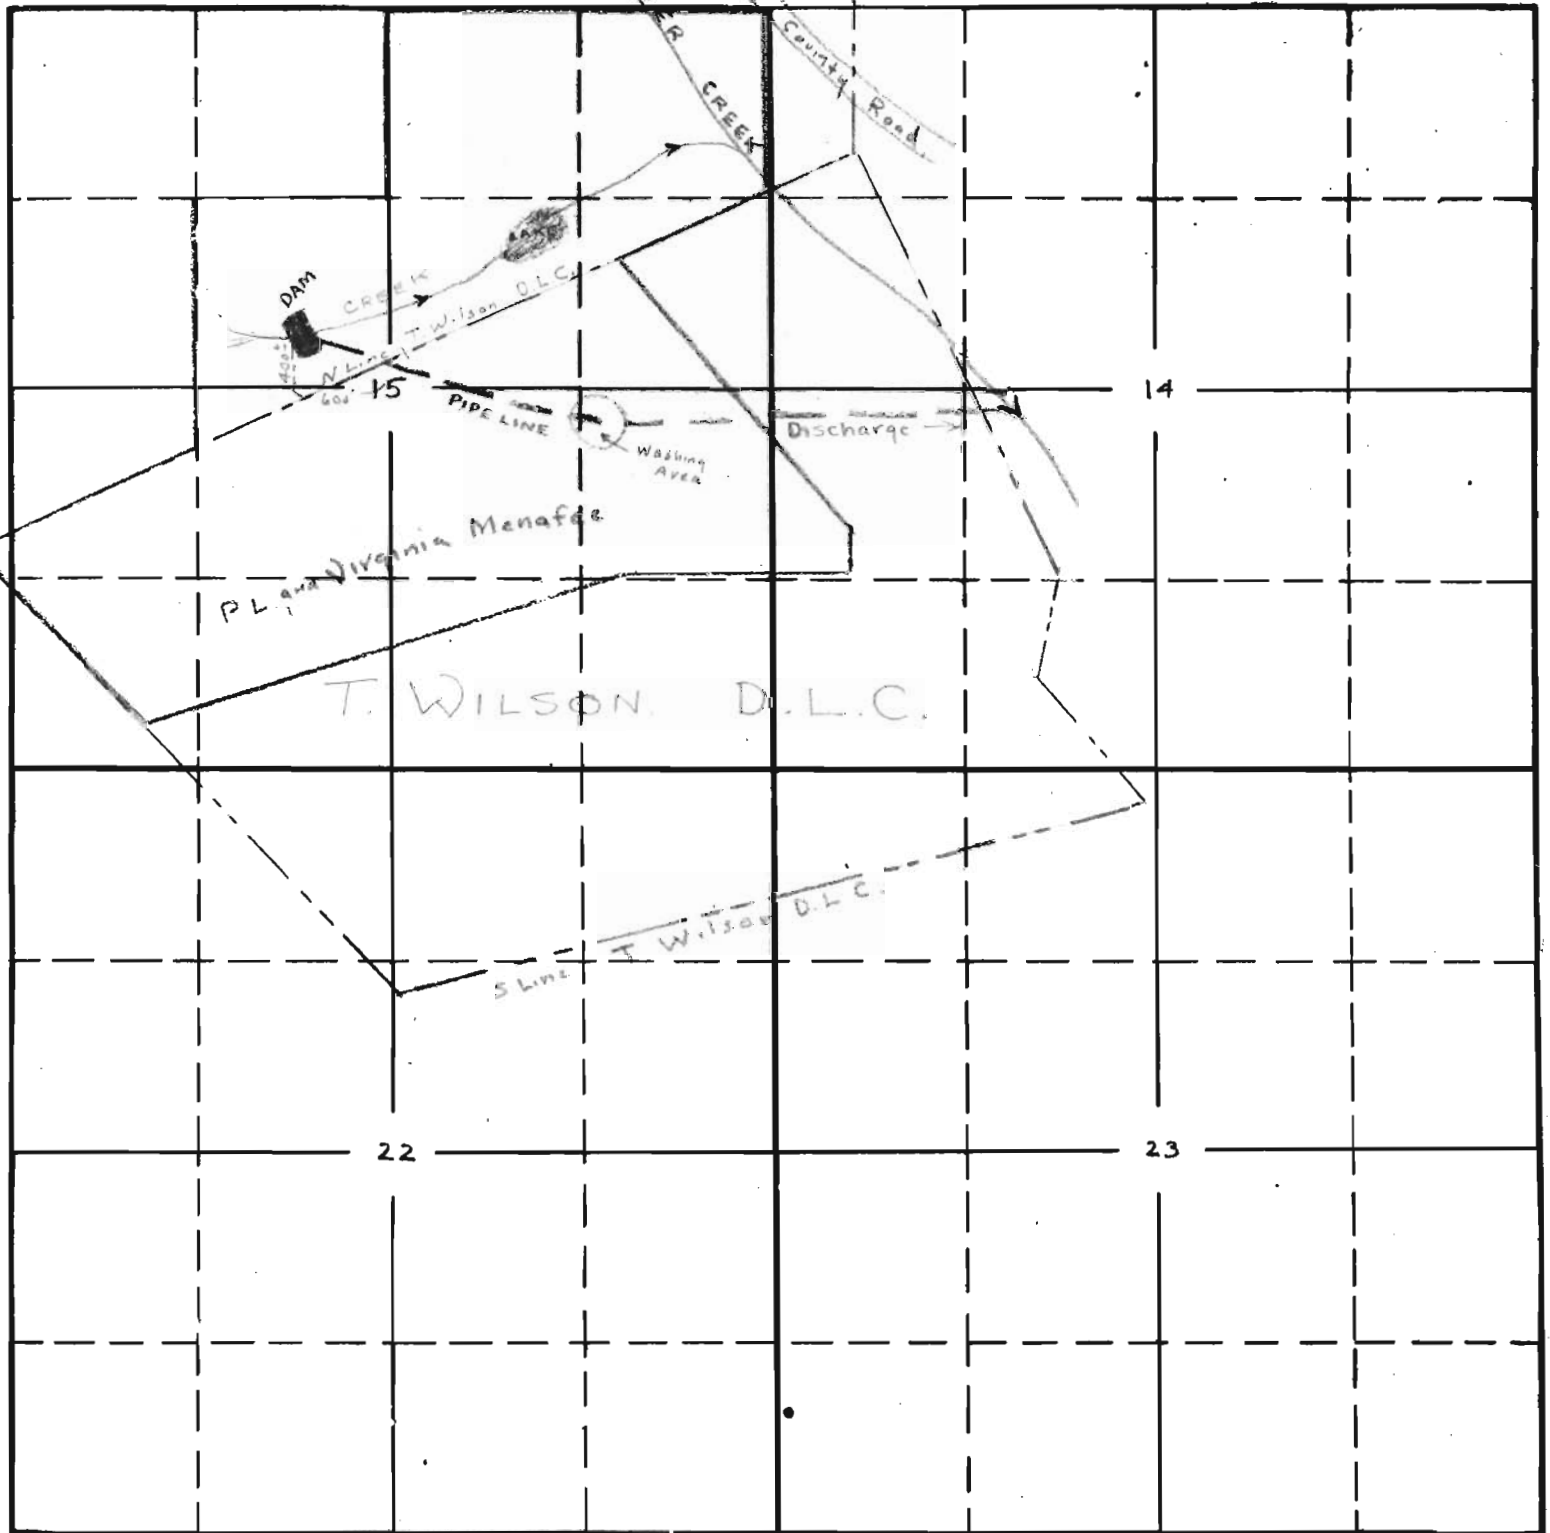

 DAM

RECEIVED

FEB 13 1947

STATE ENGINEER
SALEM OREGON

22262

2-90K

APPLICATION No. 22262

PERMIT No. 17558

Note

This creek is unnamed and rises in the NW 1/4 of Section 15, T25, R5W, W3