


SECTION

Permit: S 17561
Volume: 5B
Strm: PANNING G
Trib: COYOTE CR
Priority: 2/19/47

TOWNSHIP 33 S., RANGE 5 W.

North

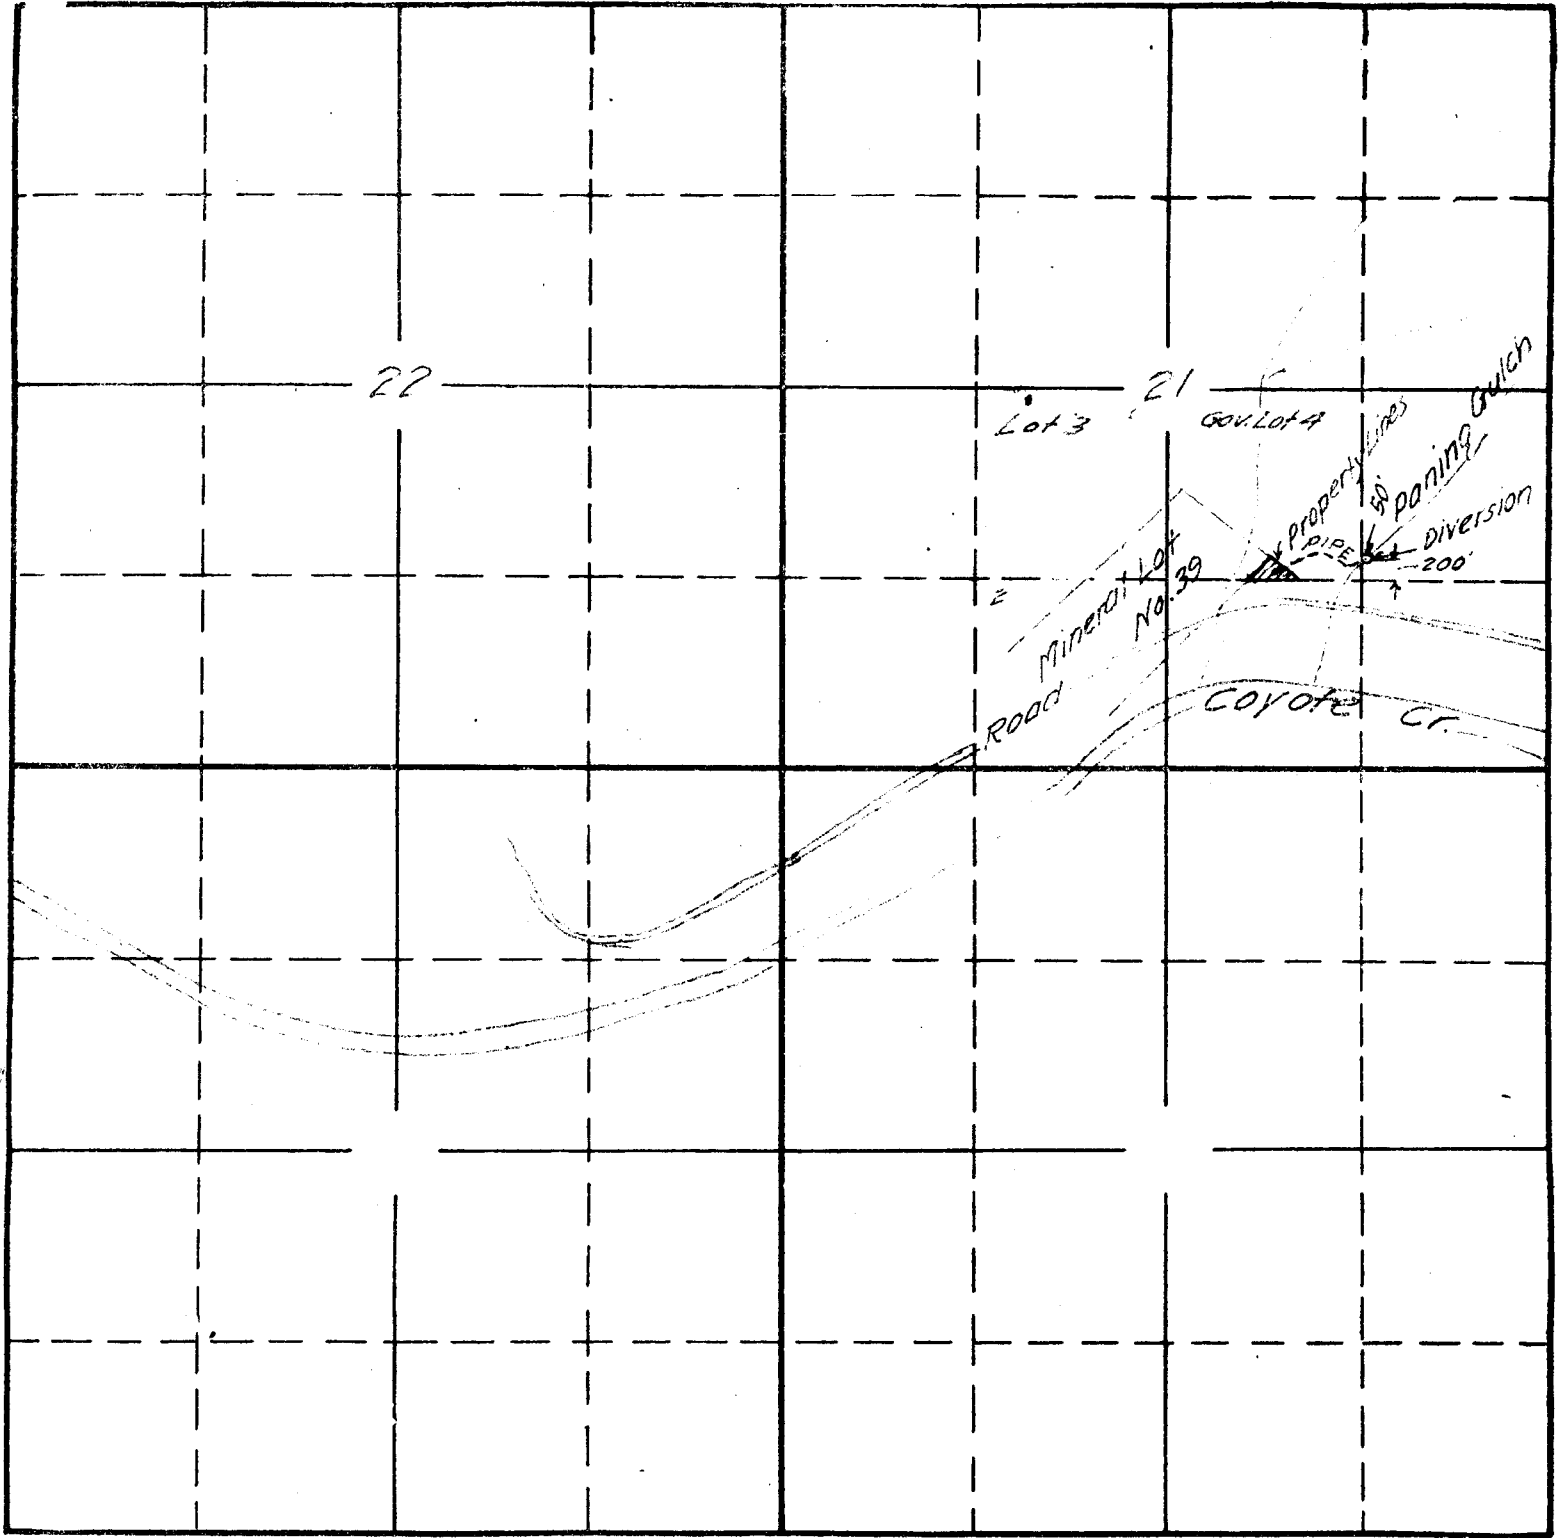

South

O. E. WYER
Feb. 1947

APPLICATION No. 22266
PERMIT No. 17561