


Permit: S 17589
Volume: 8A
Strm: ANDERSON CR
Trib: CLEAR CR
Priority: 3/04/47

T 38 S., R 8 W., W. 1

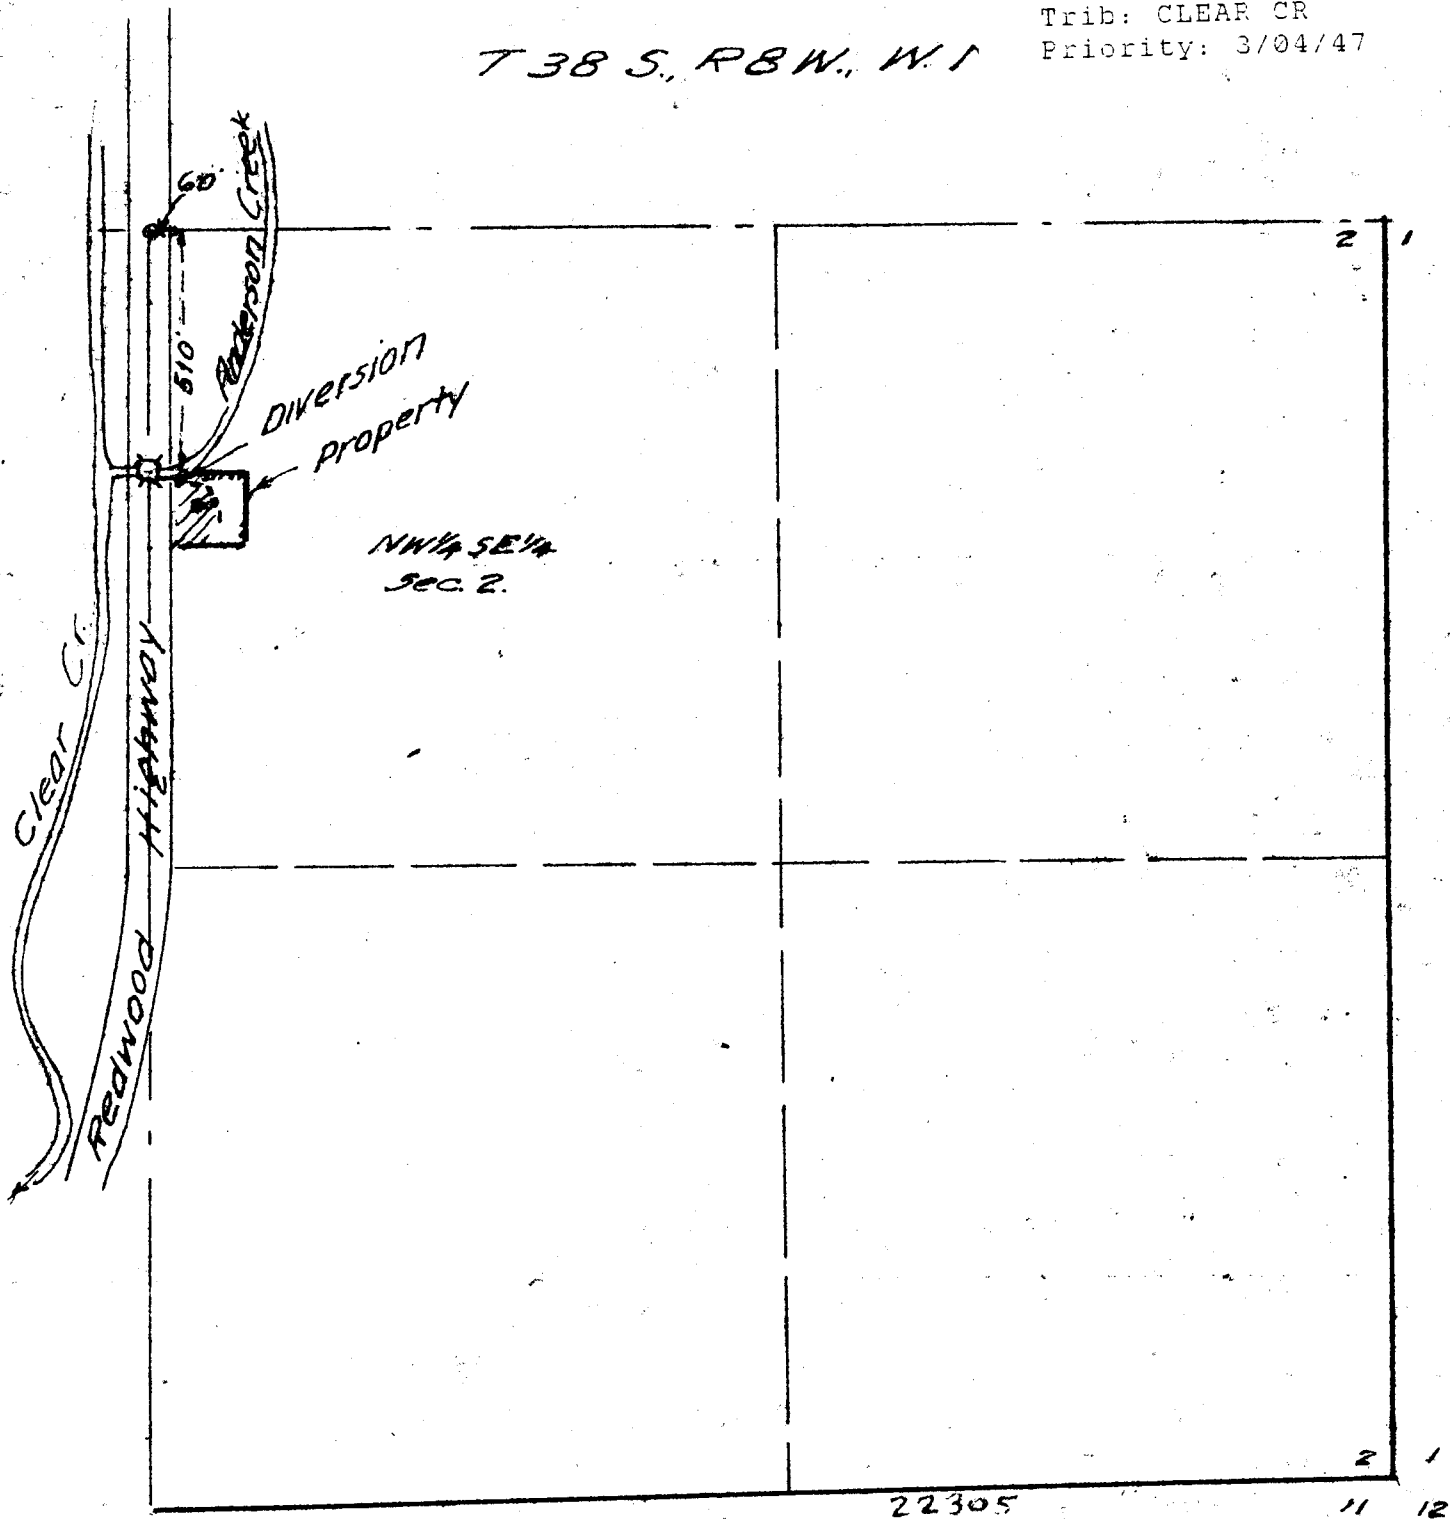

22305

2 1
11 12

E. L. CROUSE
MARCH 1947

Application No. 22305
Permit No. 17589