


SECTION

5

TOWNSHIP 38S, RANGE 14W, W. M.

North

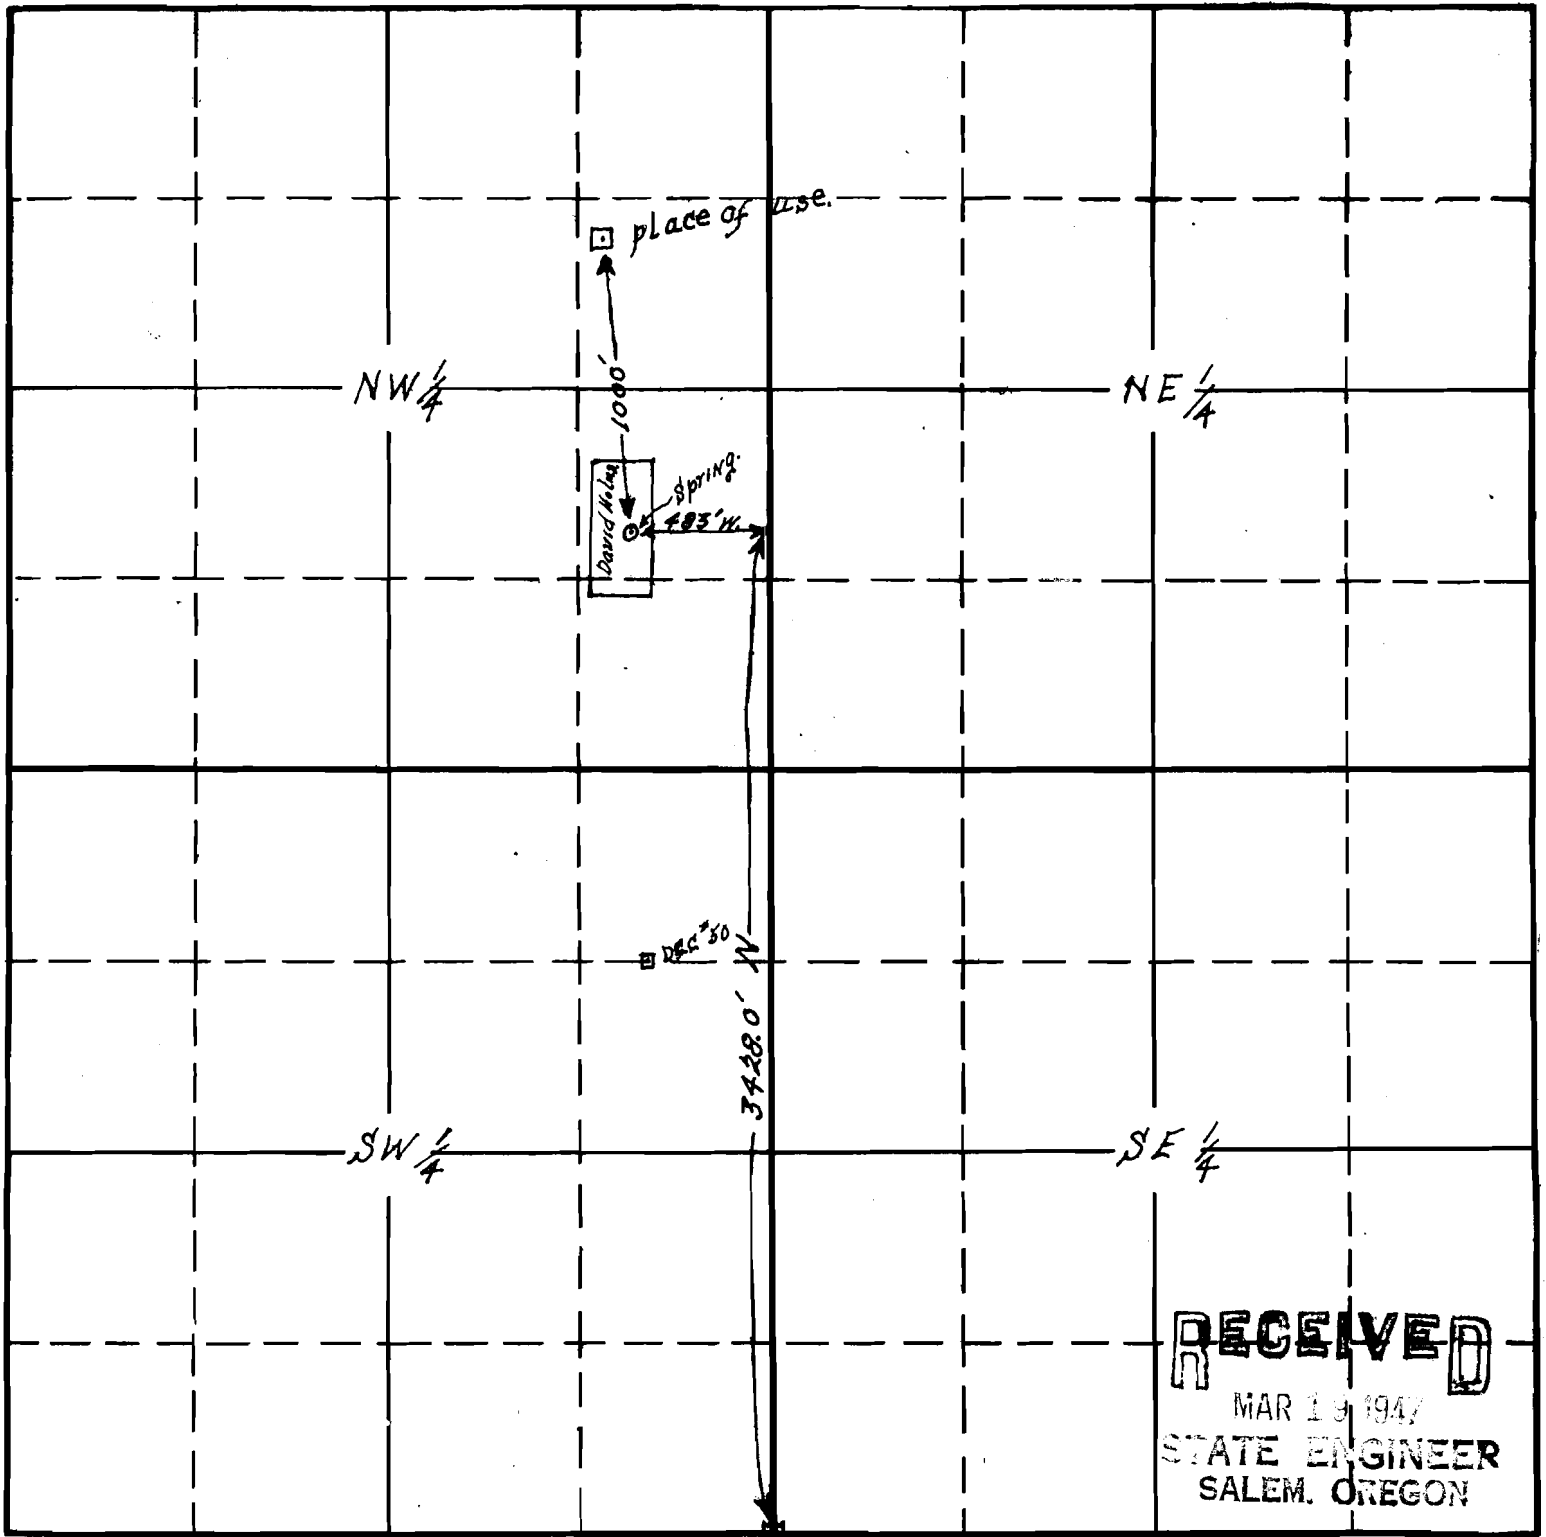

South

RECEIVED
 MAR 19 1947
 STATE ENGINEER
 SALEM, OREGON

22352

17623

Map Accompanying Application of David H. Holms,
 For Use of Water for private Spring For
 Manufacturing purposes.

APPLICATION No. 22352
 PERMIT No. 17623