


TOWNSHIP 37 S., RANGE 6 W., W. M.

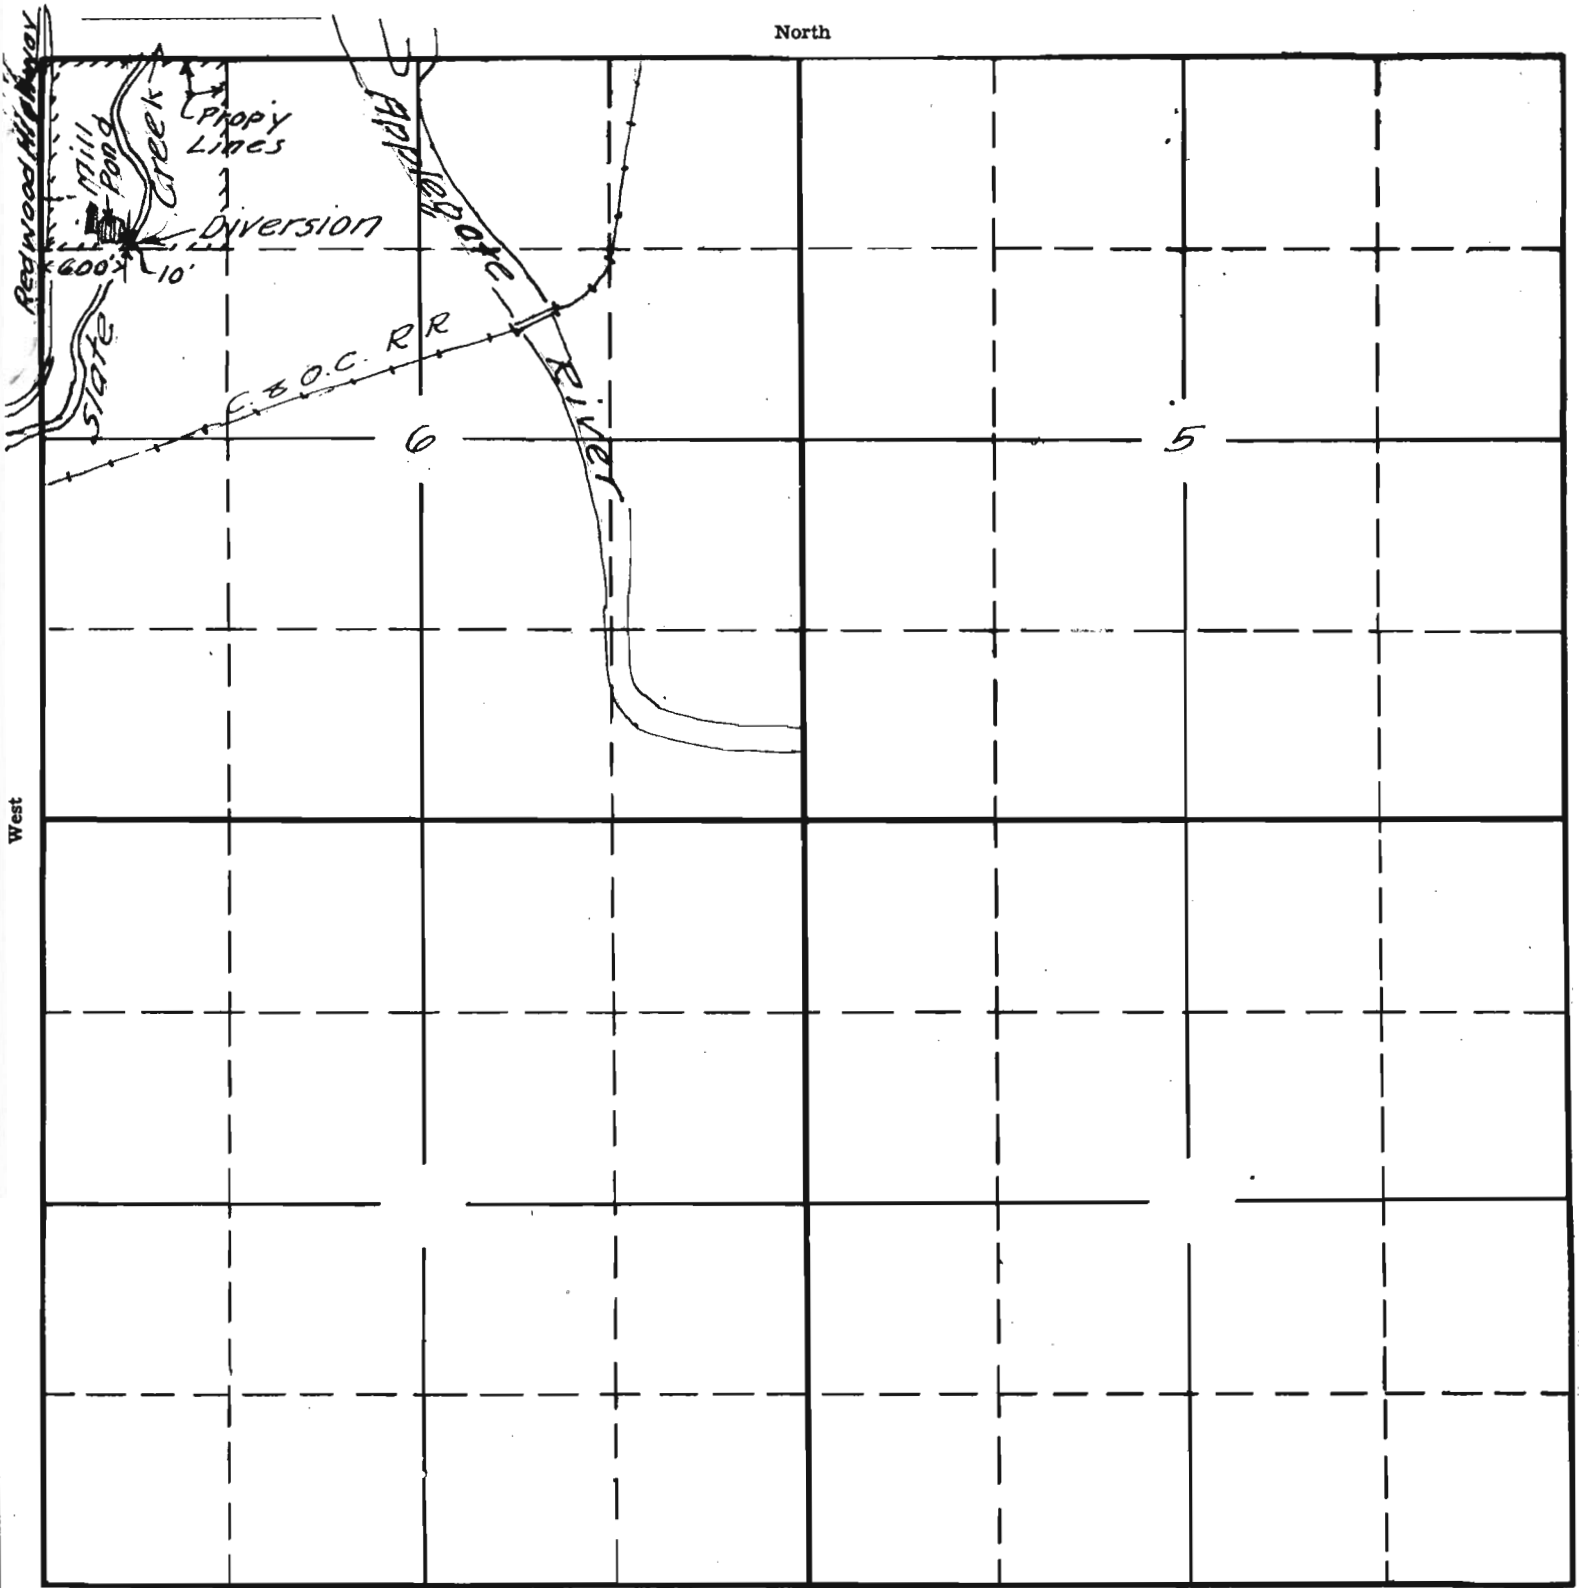

B.S.T. Lumber Co.
April 1947.

RECEIVED
APR 2 1947
STATE ENGINEER
SALEM OREGON

22394 15-16D
APPLICATION No. 22394
PERMIT No. 17653