


Permit: S 17691
Volume: 1
Stream: ROGUE R
Trib: PACIFIC OCEAN
Priority: 1/13/47
1 11 11 11

Township 34 S., Range

See Final Proof

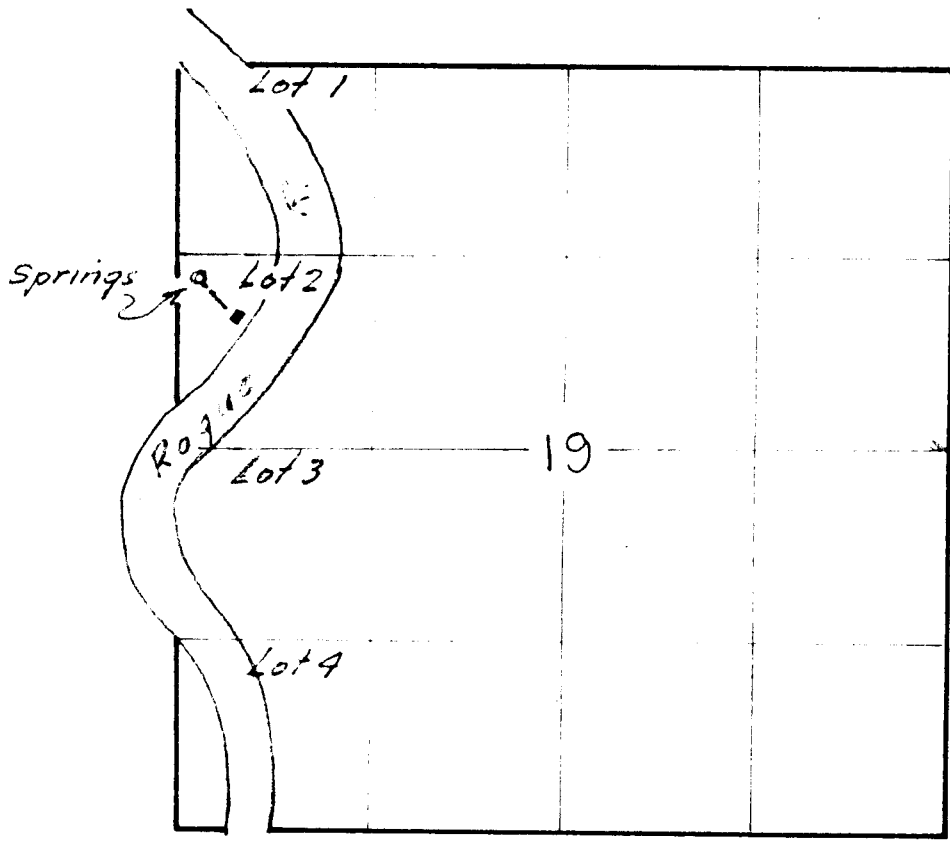

Sketch of app. map No 22181

22181


17691

TWP 34 R 8 WWM

TWP 34 R 7 WWM

13 18

24 19

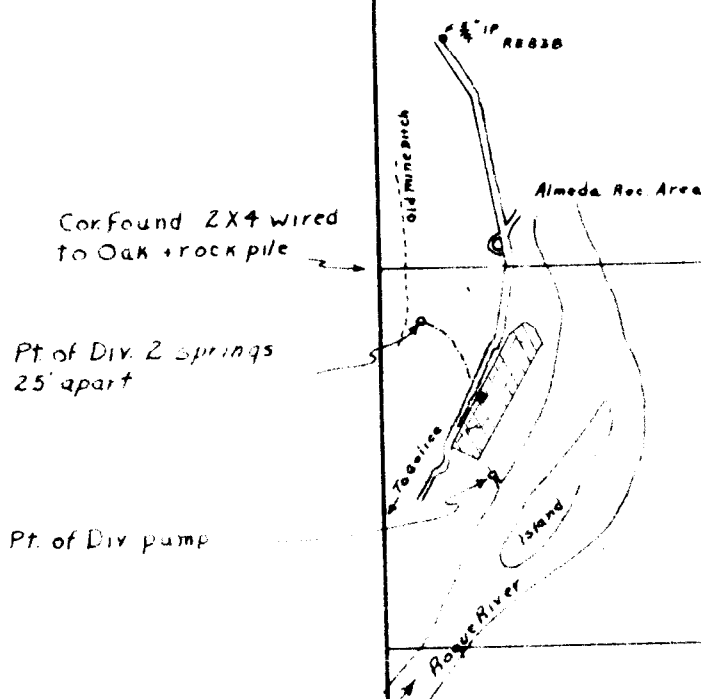

Cor. found 2x4 wired to Oak + rock pile

Pt. of Div. 2 springs 25' apart

Pt. of Div pump



Final Proof Survey Mark Krysto
 APP 22181 Per 17691
 Scale 8"=1 Mi. Oct 21 1960 By AB Steiner WM