


SECTION

25

TOWNSHIP 36 S, RANGE 7 W, W. M.

North

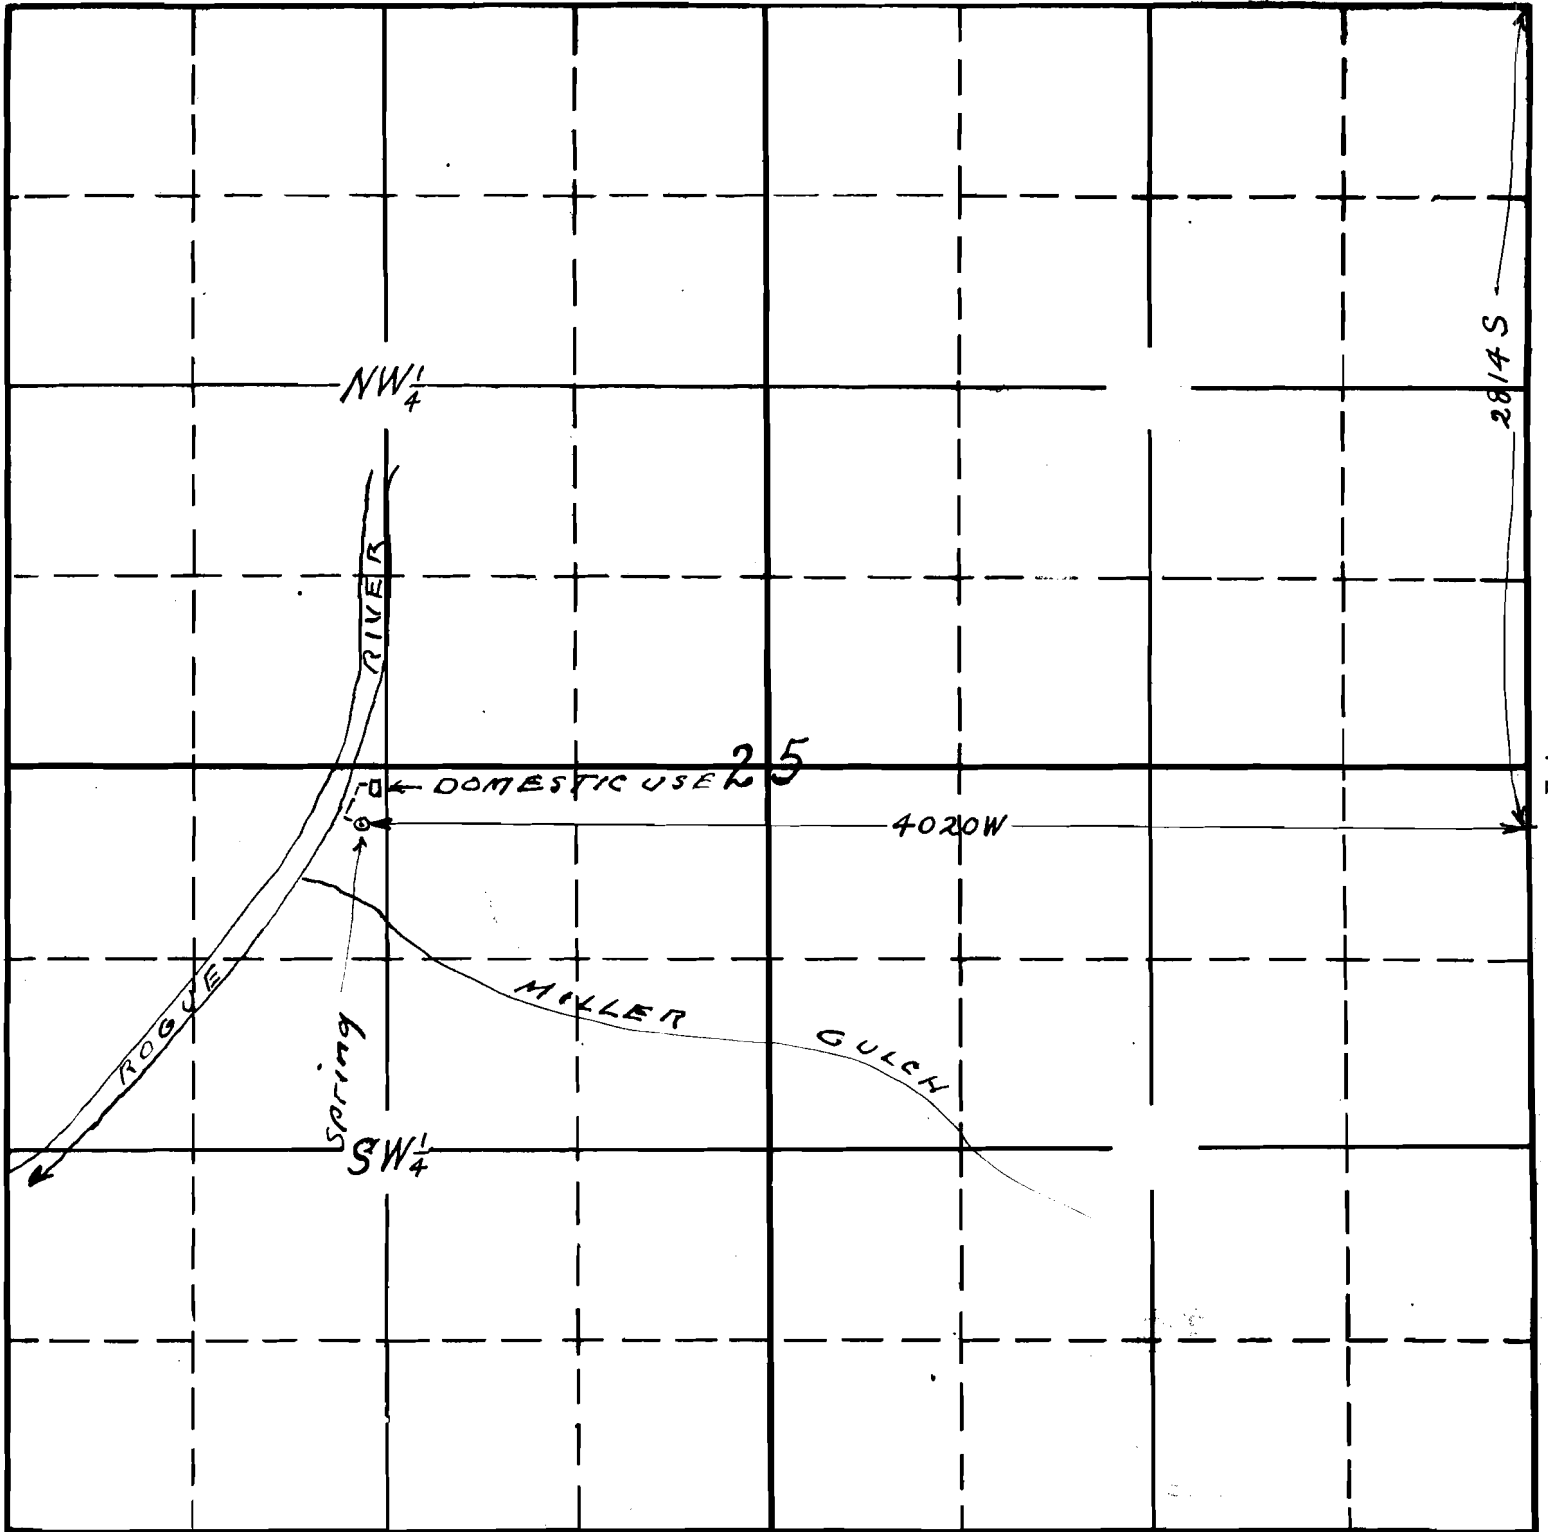

Map to accompany application of
 Dale Vincent for use of water from
 private spring for domestic purposes

South

APPLICATION No. 22327
 PERMIT No. 3892

This office 3/5/47