


Handwritten note in a circle:
22633
15-78F

22633
15-78F

Application No. 22633
Permit No. 10786

17

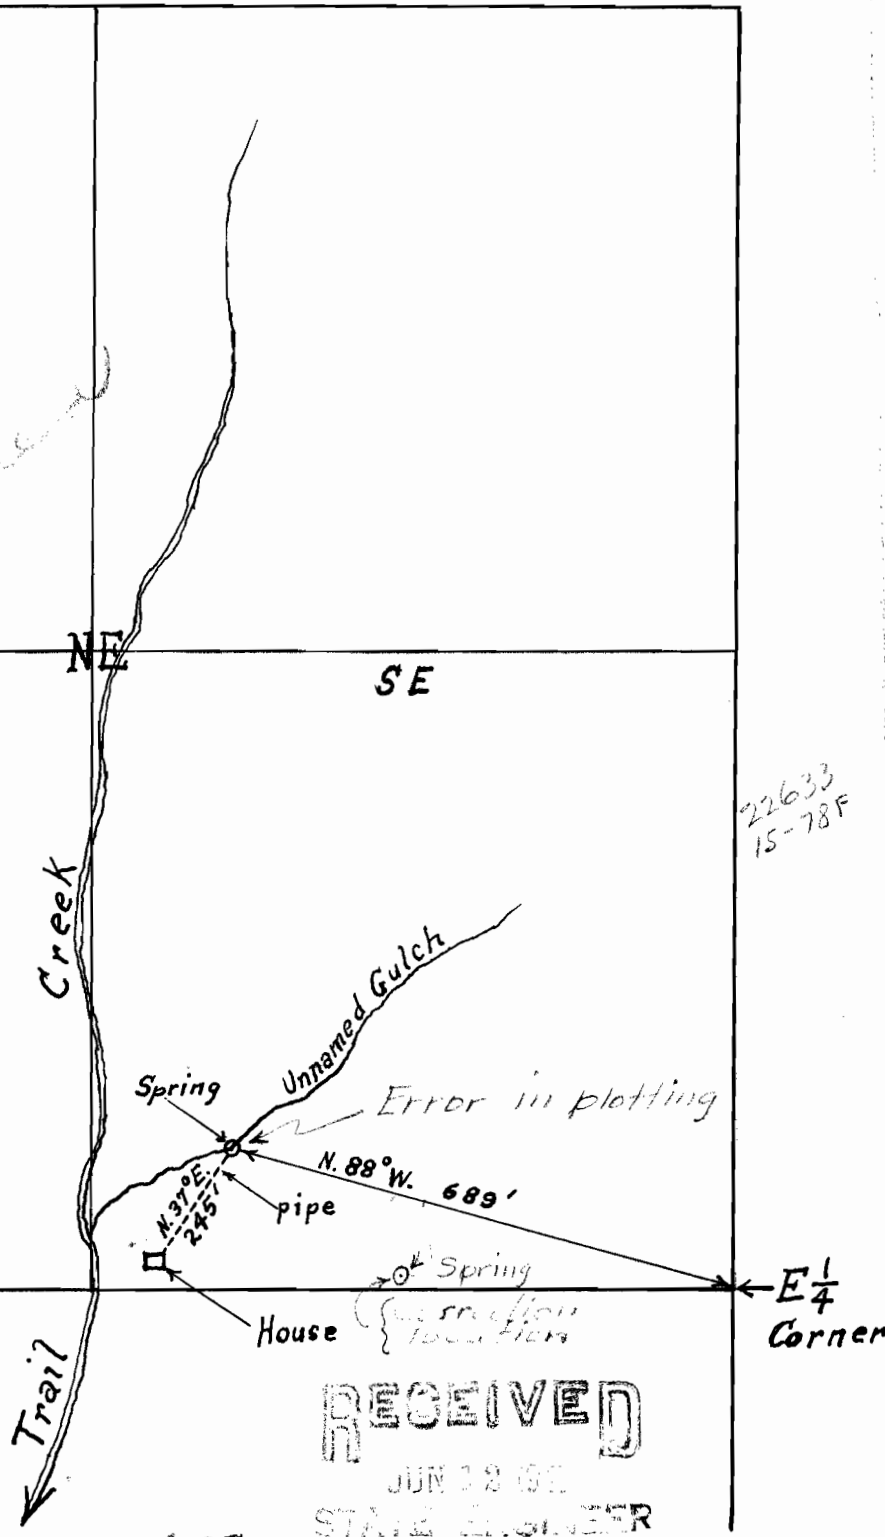

Map for application of
W.H. Cushman for domestic
use of spring

RECEIVED
JUN 28 1947
STATE ENGINEER
SALEM, OREGON

22633

This office 6-6-47 CMS