


SECTION

35

TOWNSHIP 35S, RANGE 1W, W. M.

North

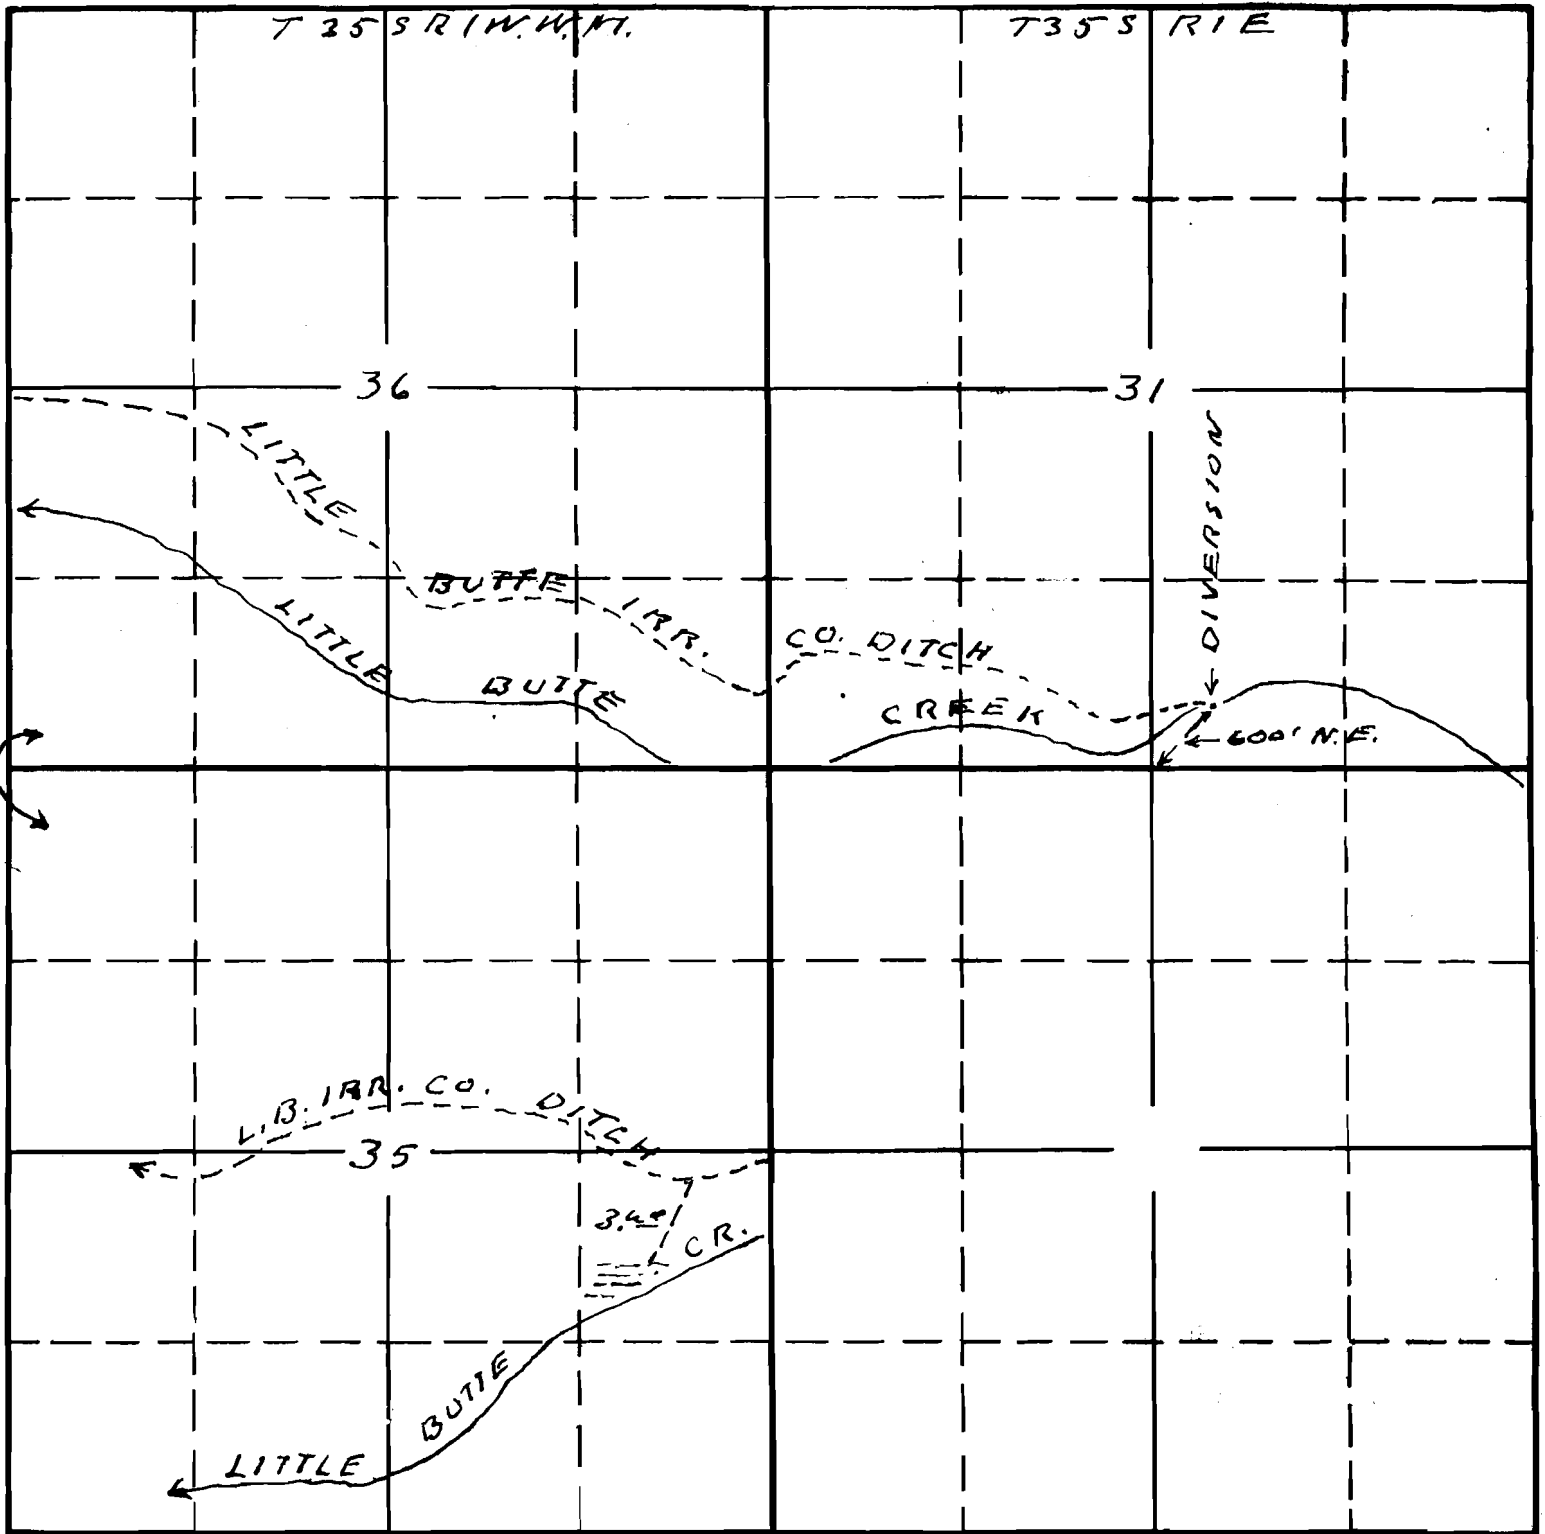

Map To accompany application of C. R. Elbert for use of water from Little Butte Co. for irrigation

APPLICATION No. 22335
PERMIT No. 17803

This office 3/13/47 *Smith*