


5

TOWNSHIP 37 S, RANGE 2 W, W. M.

North

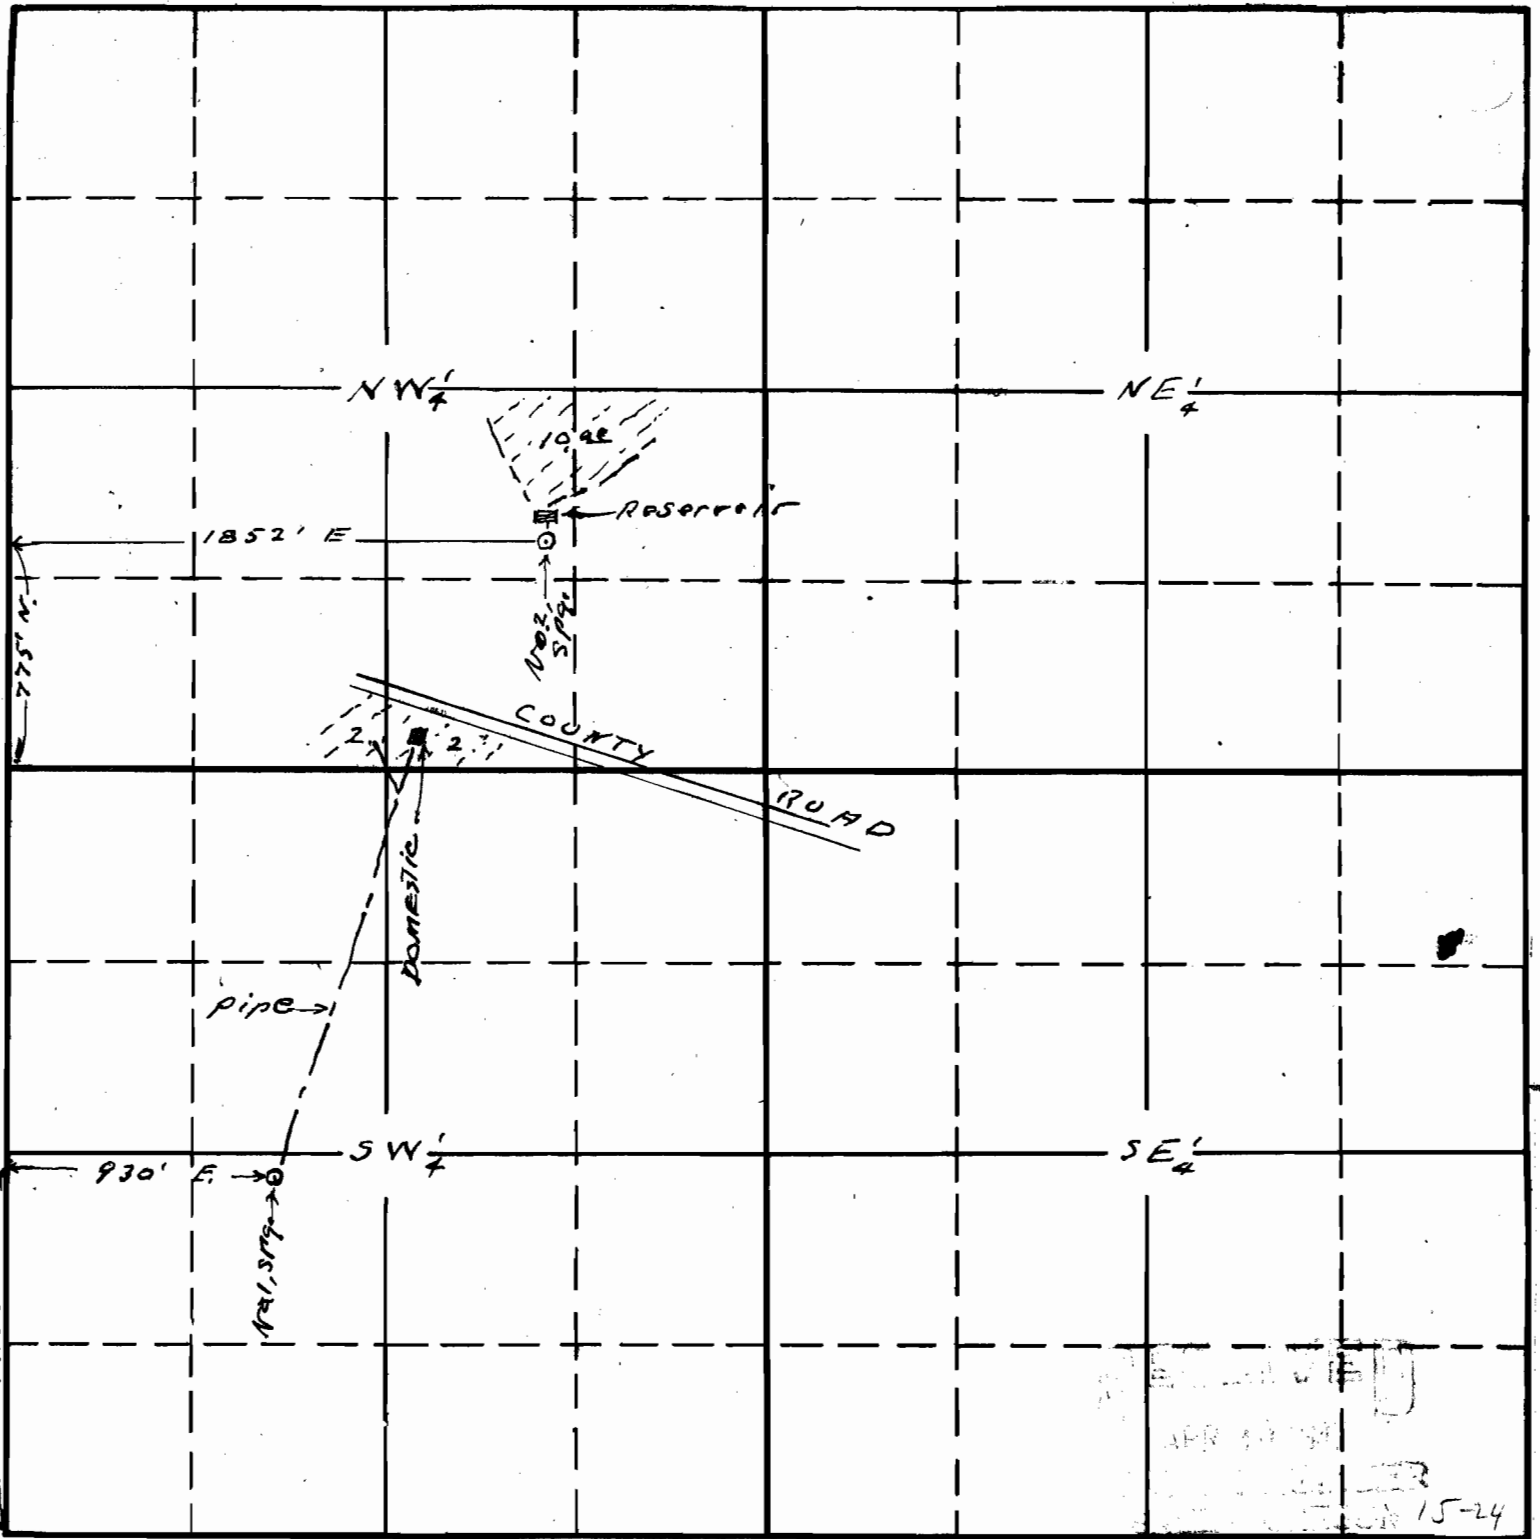

South

R-22478

22479

Map to accompany application of
 Frank C Dean for use of waters from
 No. 1 & No. 2 private springs for domestic
 and irrigation purposes.
 Reservoir to be filled and used from No. 2 spg.

APPLICATION No.

PERMIT No.

R-22478
22479

This office 7/24/147 *Whitt*