


T. 4S. R. 12&13E. W.M.

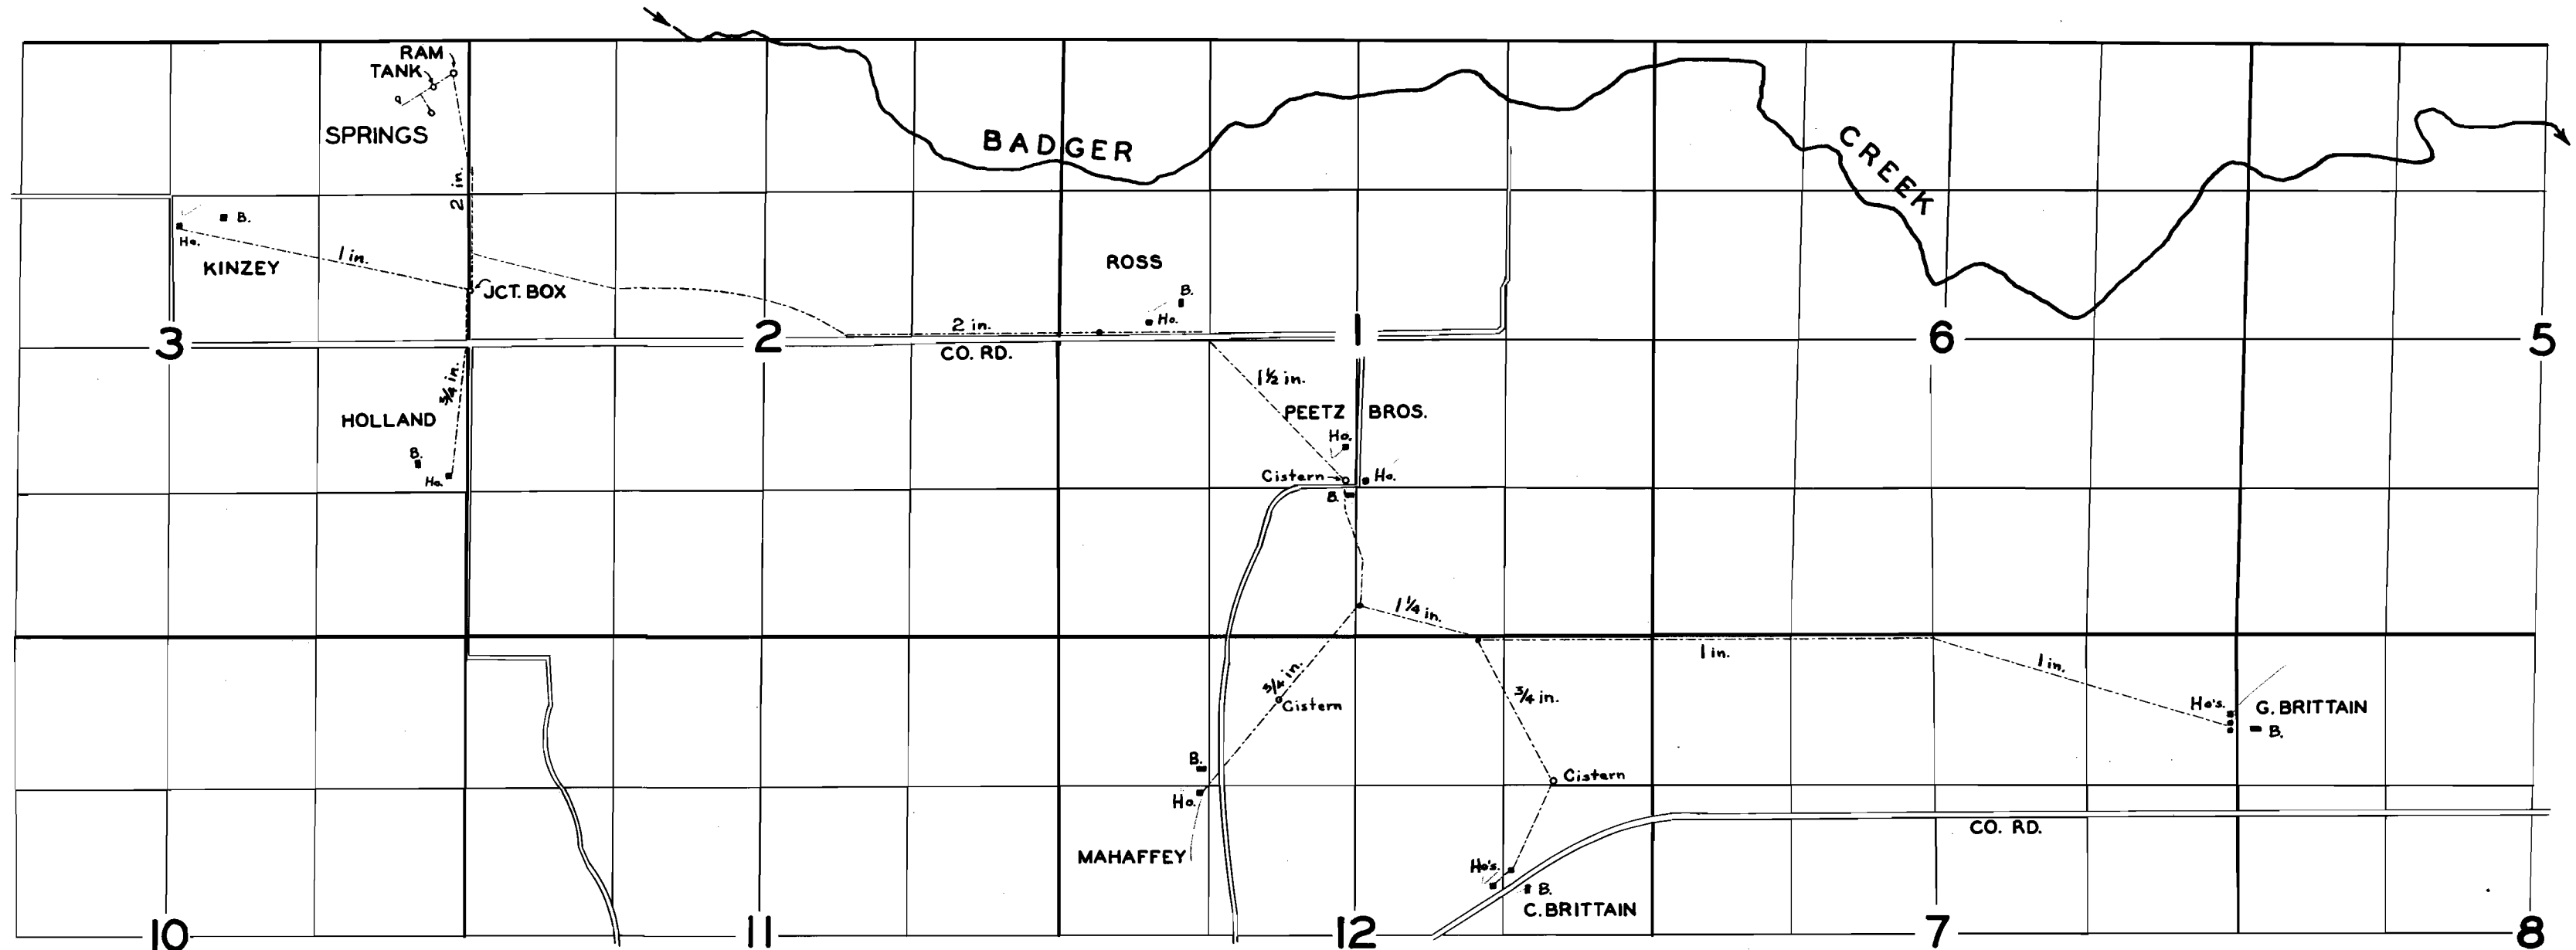

FINAL PROOF SURVEY

UNDER

Application No. 21644. Permit No. 17901

IN NAME OF SHEAR SPRING WATER ASSOCIATION, INC.

Surveyed OCT. 22 1957, by M. Bish

Application No. 33049
Permit No. 26140