


T.3S, R.45E.W.M.

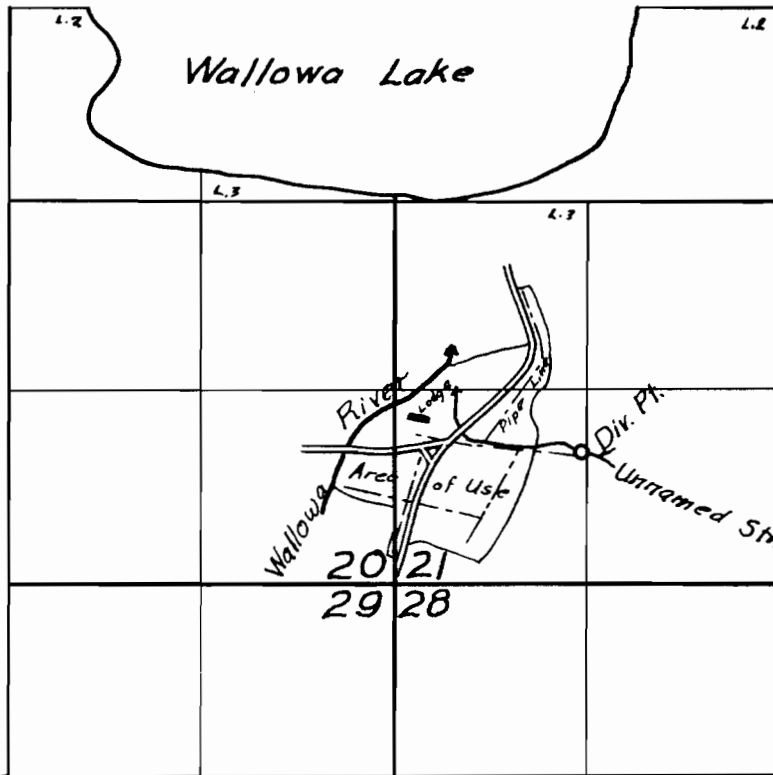

FINAL PROOF SURVEY

UNDER

Application No. 22799. Permit No. 1794B.

IN NAME OF

CHIEF JOSEPH RESORT WATER DIST.

Surveyed 18 October 1955, by *Robert H. [Signature]*