


T. 39 S., R. 2 W. W.M.

Sec. 9

Map to accompany application
of Vernon R Guches for use
of water from spring in Demming
gulch for domestic purposes

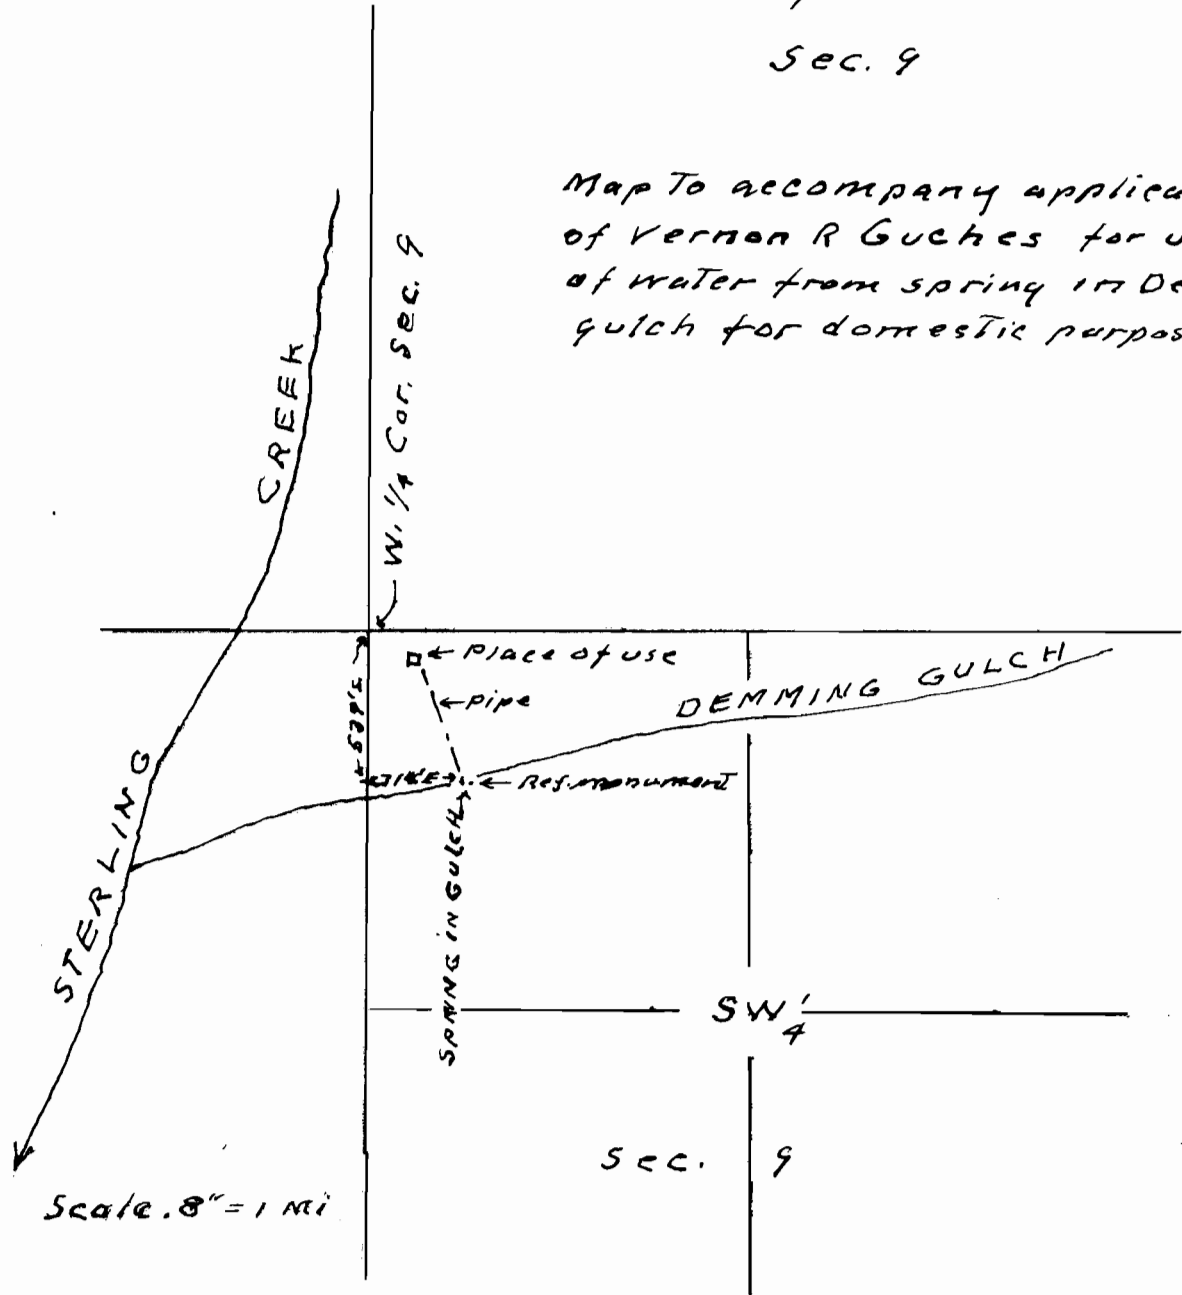

Scale 8" = 1 Mi

This office 9/12/47
W. Smith

Application No. 22809
Permit No.