


SECTION

TOWNSHIP 39 S, RANGE 8 W., W. M.

North

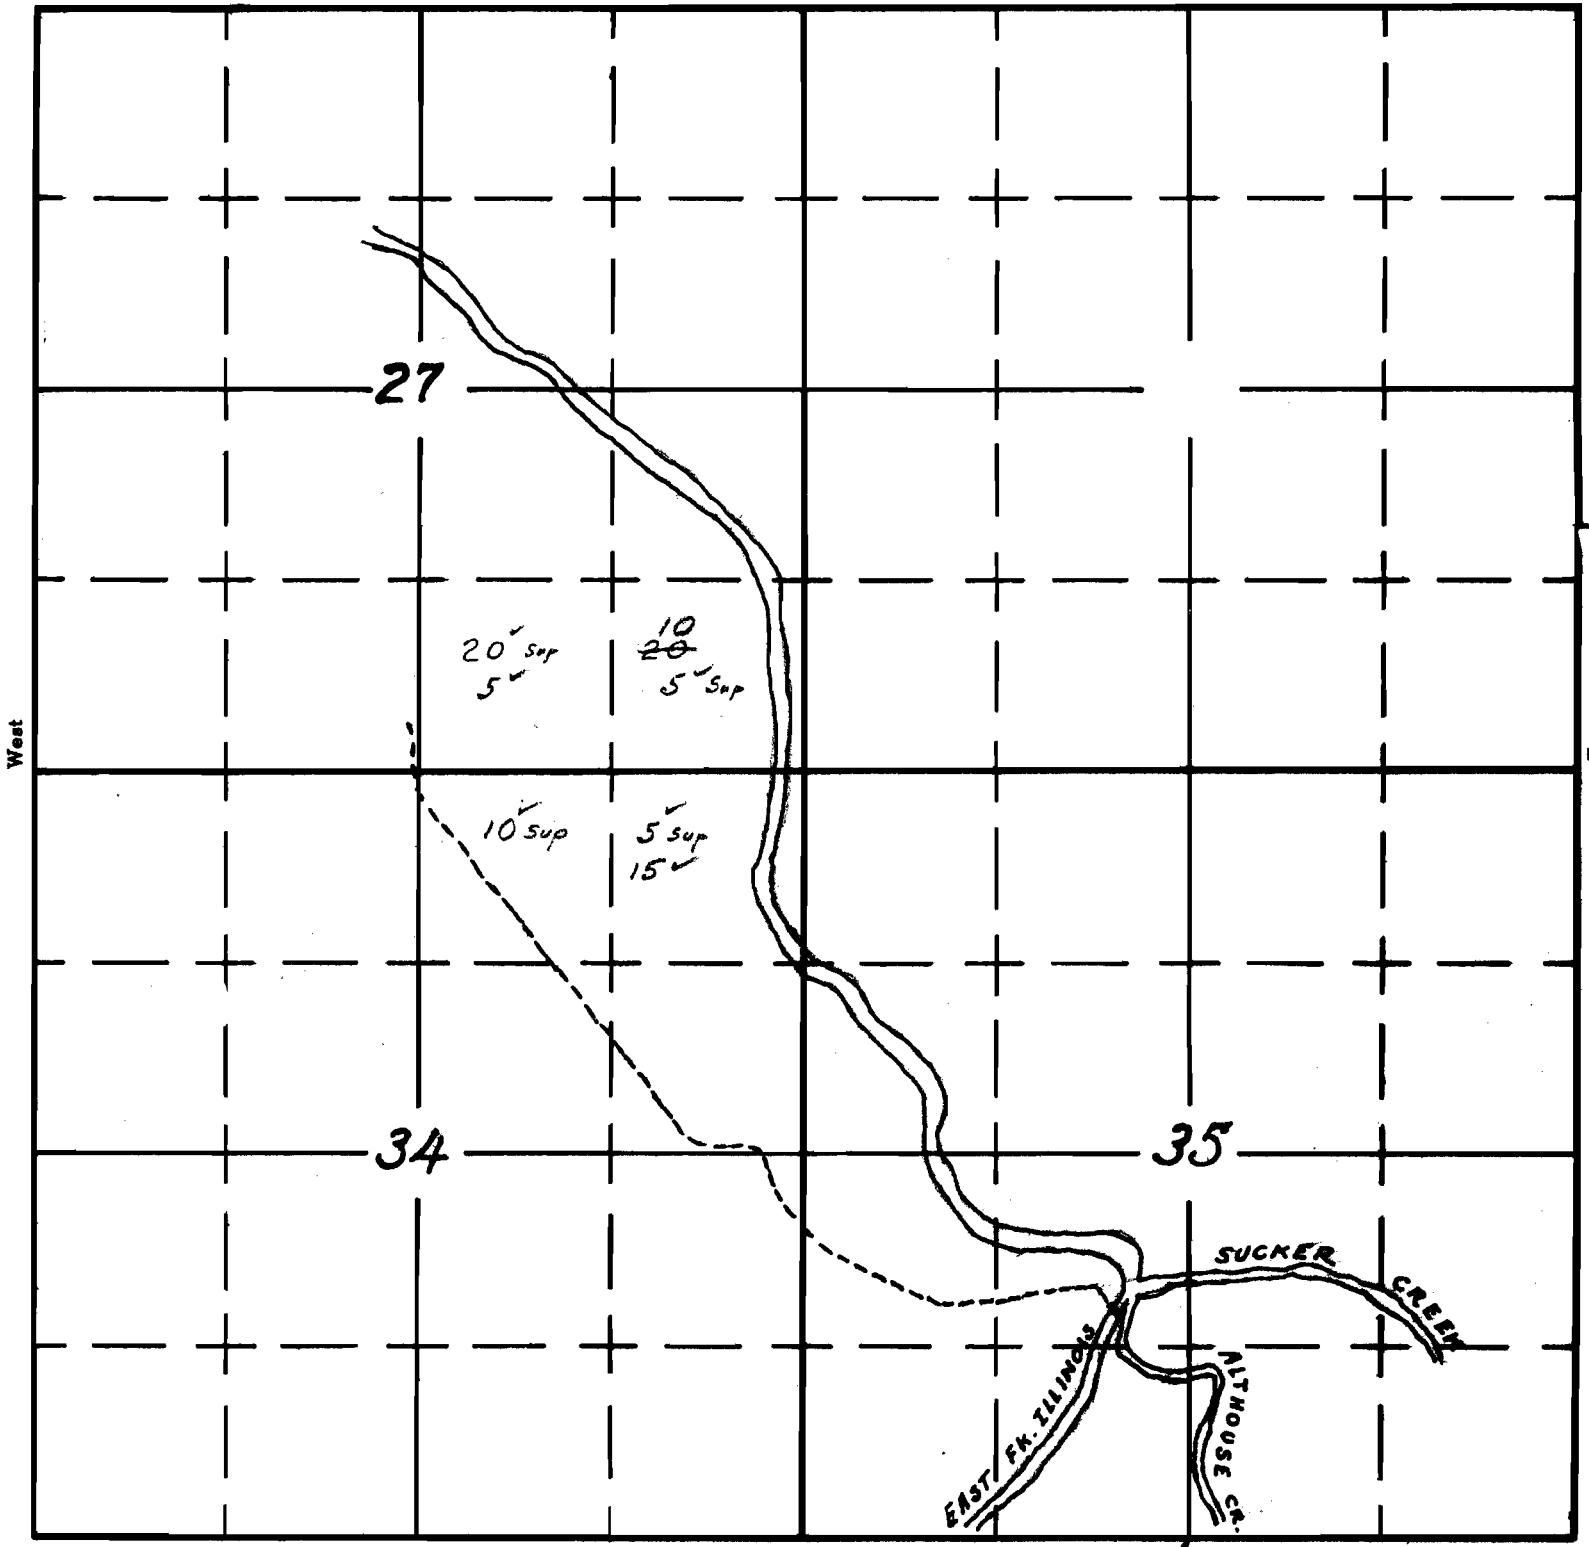

West

East

South

22830

Application No. 22830
Permit No. 17982