


Section 28

TOWNSHIP 2 S. RANGE 9 W, W.M.

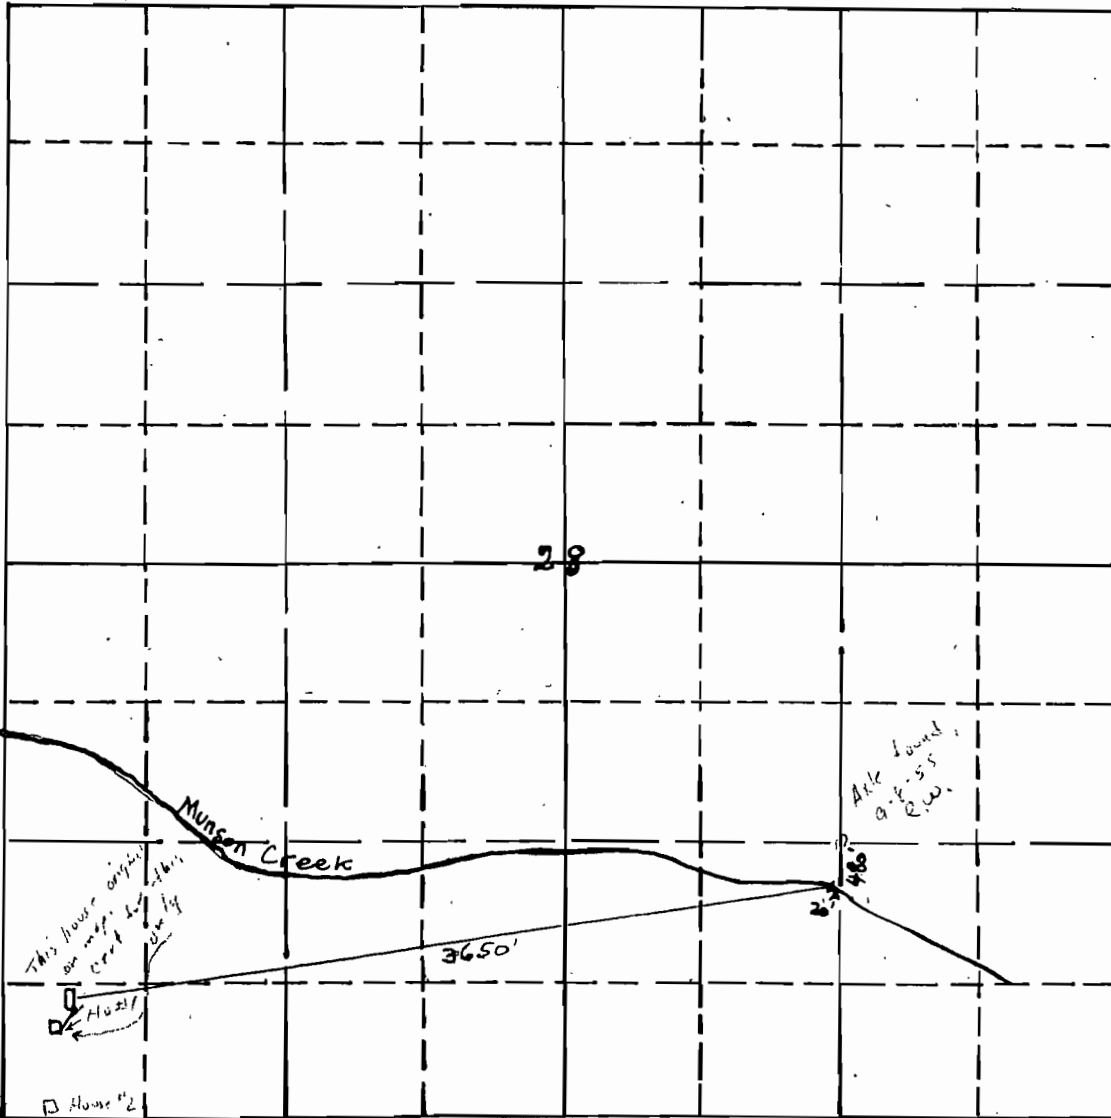

140<sup>W</sup> 3<sup>Q</sup>  
By Field Eng'r

By field Eng'r report.

22860

1-18

Application No. 22860  
Permit No. 17989

RECEIVED  
JAN 18 1918  
SHERIFF'S OFFICE