


37-6

T. 37 S., R. 6 W., W. M.

Scale 4" = 1 Mile

Nov. 1947

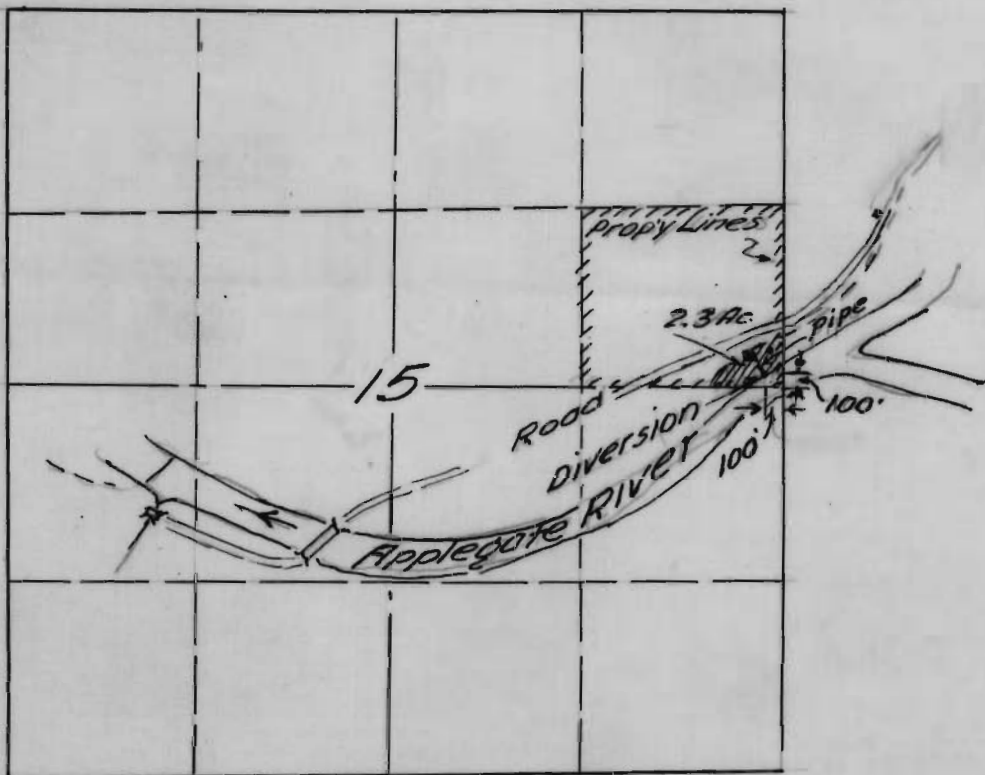

22922

15-8A

W. B. Yates

Application No. 22922

Permit No. 18004

RECEIVED

NOV 21 1947

STATE ENGINEER  
SALEM, OREGON