


TWP 33 S R 6 W W M

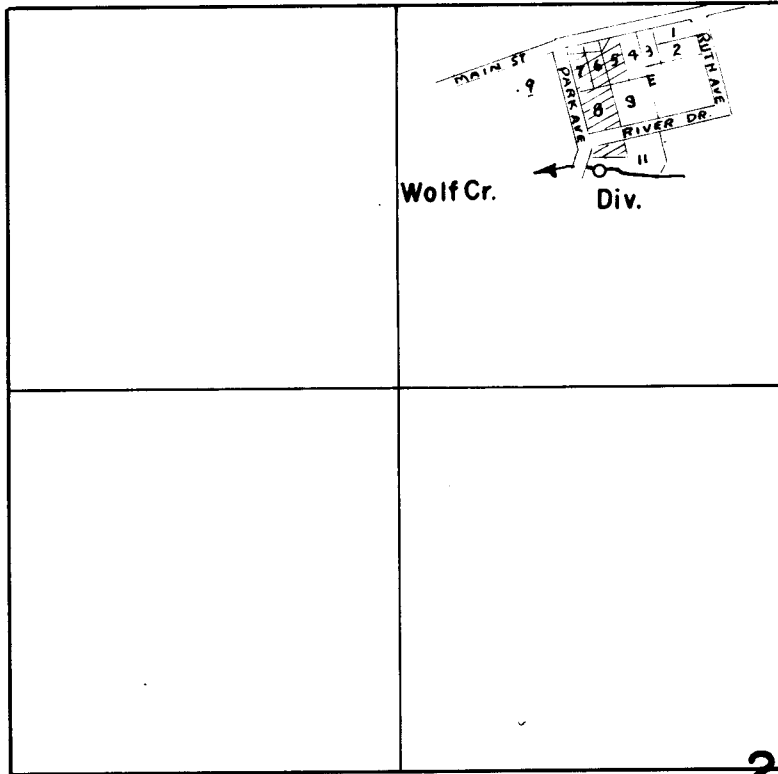

NW 1/4

Scale 8" = 1 Mi.

FINAL PROOF SURVEY UNDER

Application No. 35599 Permit No. 27548
IN NAME OF

JOHN RONCHI

Surveyed 6-20 1963, by R Steimer