

18122

FROM:


RECEIVED

SEP 13 1983

T. 4N. R. 29E. W.M. WATER RESOURCES DEPT. SALEM, OREGON

T-5369

5

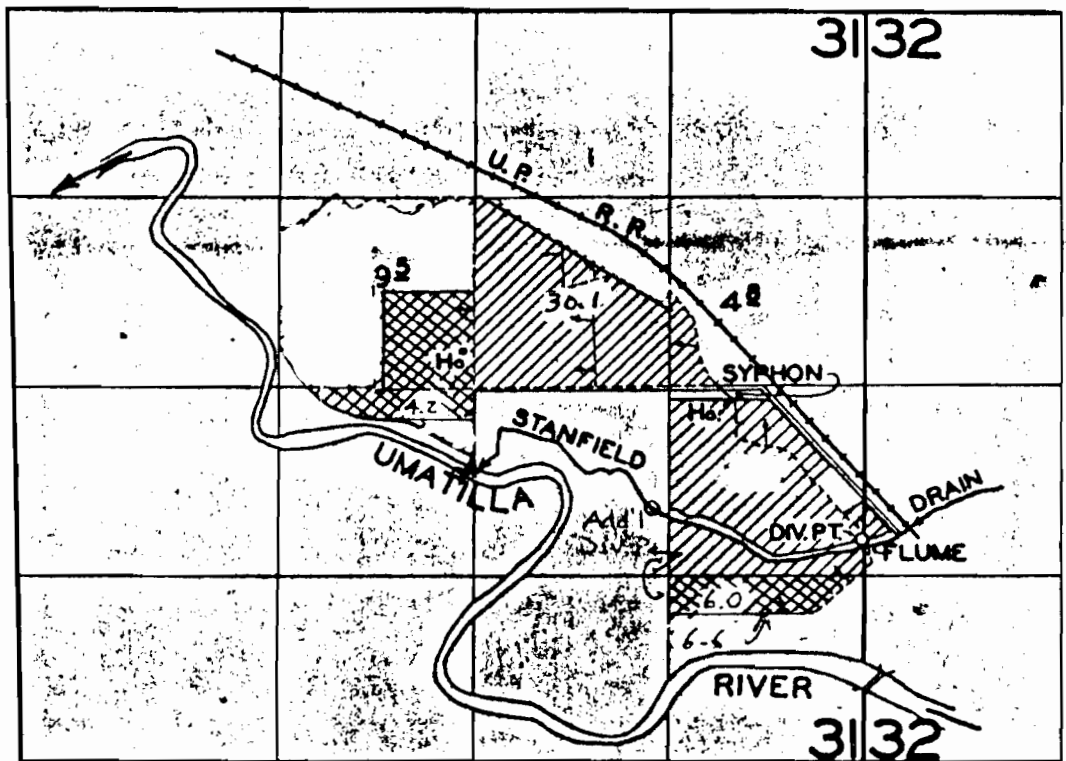

Add'l Div. Pt. used 1800, 3 & 150000 From NE Cor Sec. 31



PRIMARY



SUPPLEMENTAL

~~FINAL PROOF SURVEY~~
UNDER

Application No. 22914.. Permit No. 18122....
IN NAME OF

J.J. OBERSON & L.M. GOSSLER.....

Surveyed MAY 16, 1957., by C.O. Butcher

RECEIVED

FEB 21 1984

WATER RESOURCES DEPT. SALEM, OREGON