


T. 9 S., R. 2 W., W.M.

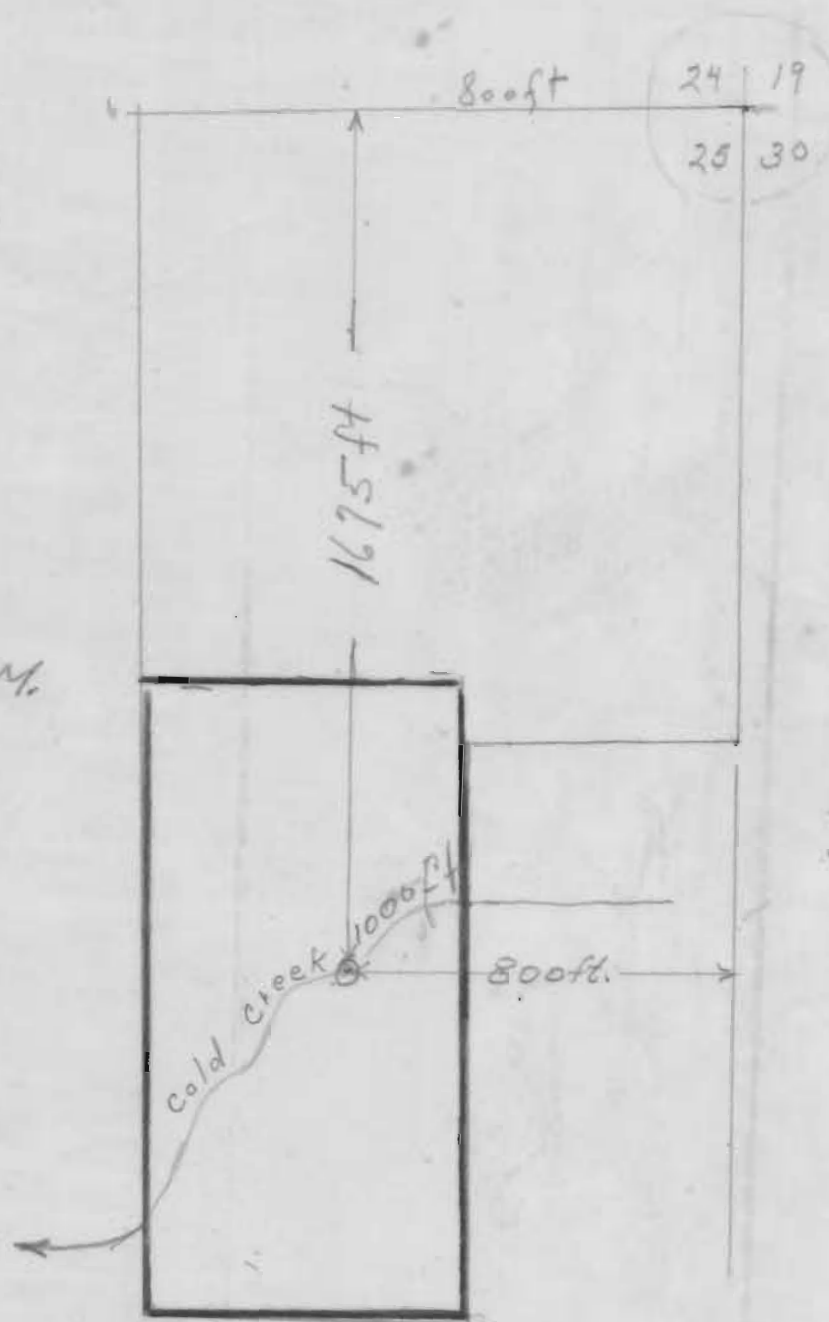

Application No. 22977
Permit No. 18130

1 inch equals 400 feet