


SEC. 10, T. 35 S. R. 8 W. W.M.

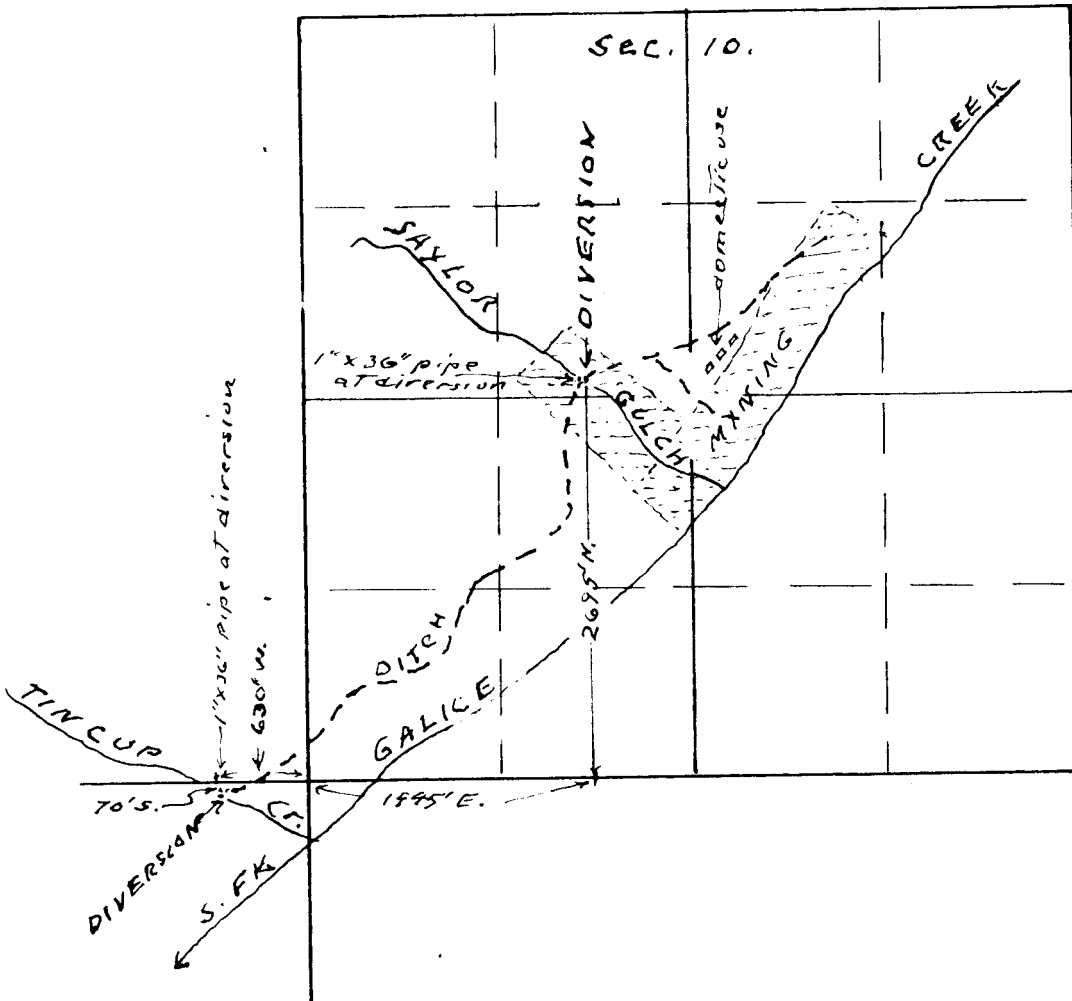

This office 3/16/48 J.R. Smith W.M.

Appl. 23085
Per. 18176