

MAP OF SMITH'S IRRIGATION DITCH.


Located in Tp 3 S, R11 & 12 E, W.M.

Showing correct location of Ditch after being completed.


B. F. Smith
Surveyor.

Scale 2 in = 1 mile.

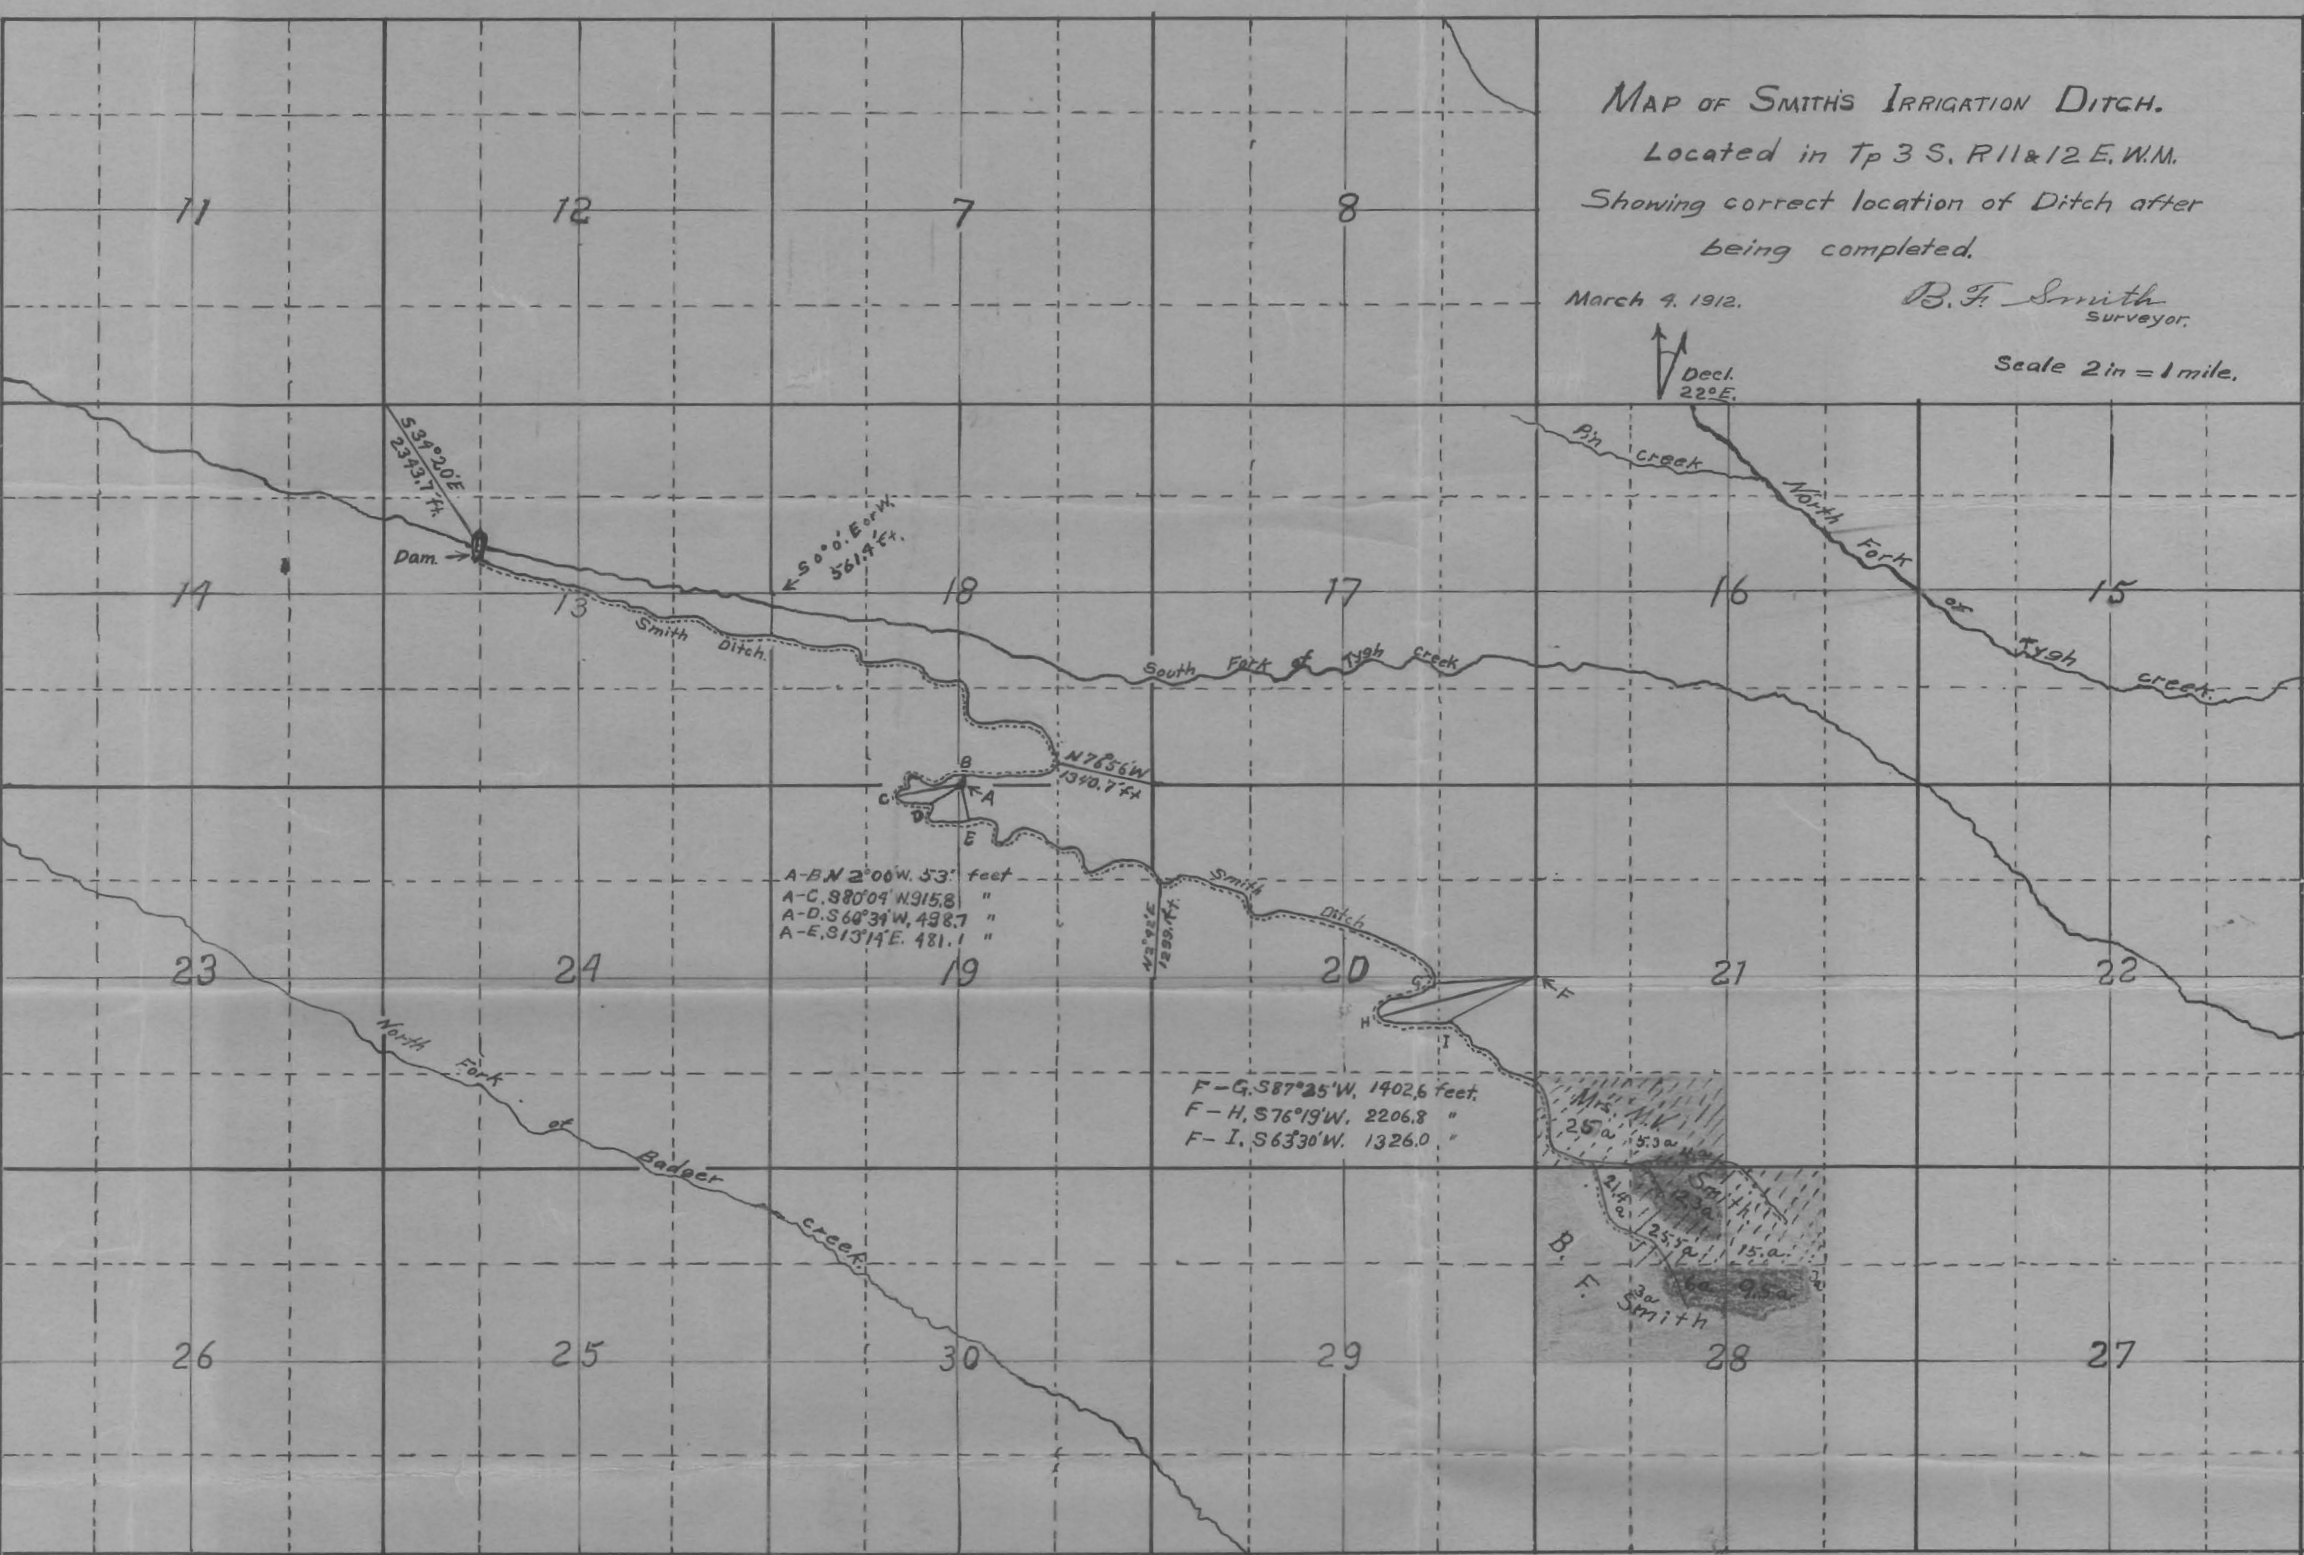

A-B, N 2° 00' W, 53.7 feet
 A-D, S 60° 31' W, 498.7 "
 A-E, S 13° 14' E, 481.1 "

F-G, S 87° 25' W, 1402.6 feet
 F-H, S 76° 19' W, 2206.8 "
 F-I, S 63° 30' W, 1326.0 "

Township 3 South, Range 11 East, W.M.

Township 3 South, Range 12 East, W.M.

Legend


- Irrigated Land in Cultivation.
- Irrigated Pasture Land.
- Land not Irrigated at Present.

Map of Smith's Irrigation Ditch. Showing correct location of Ditch after being completed.

Township _____, Range _____.

Township 3 South. Range 11. East. W.M.

Township 3 South. Range 12. East. W.M.

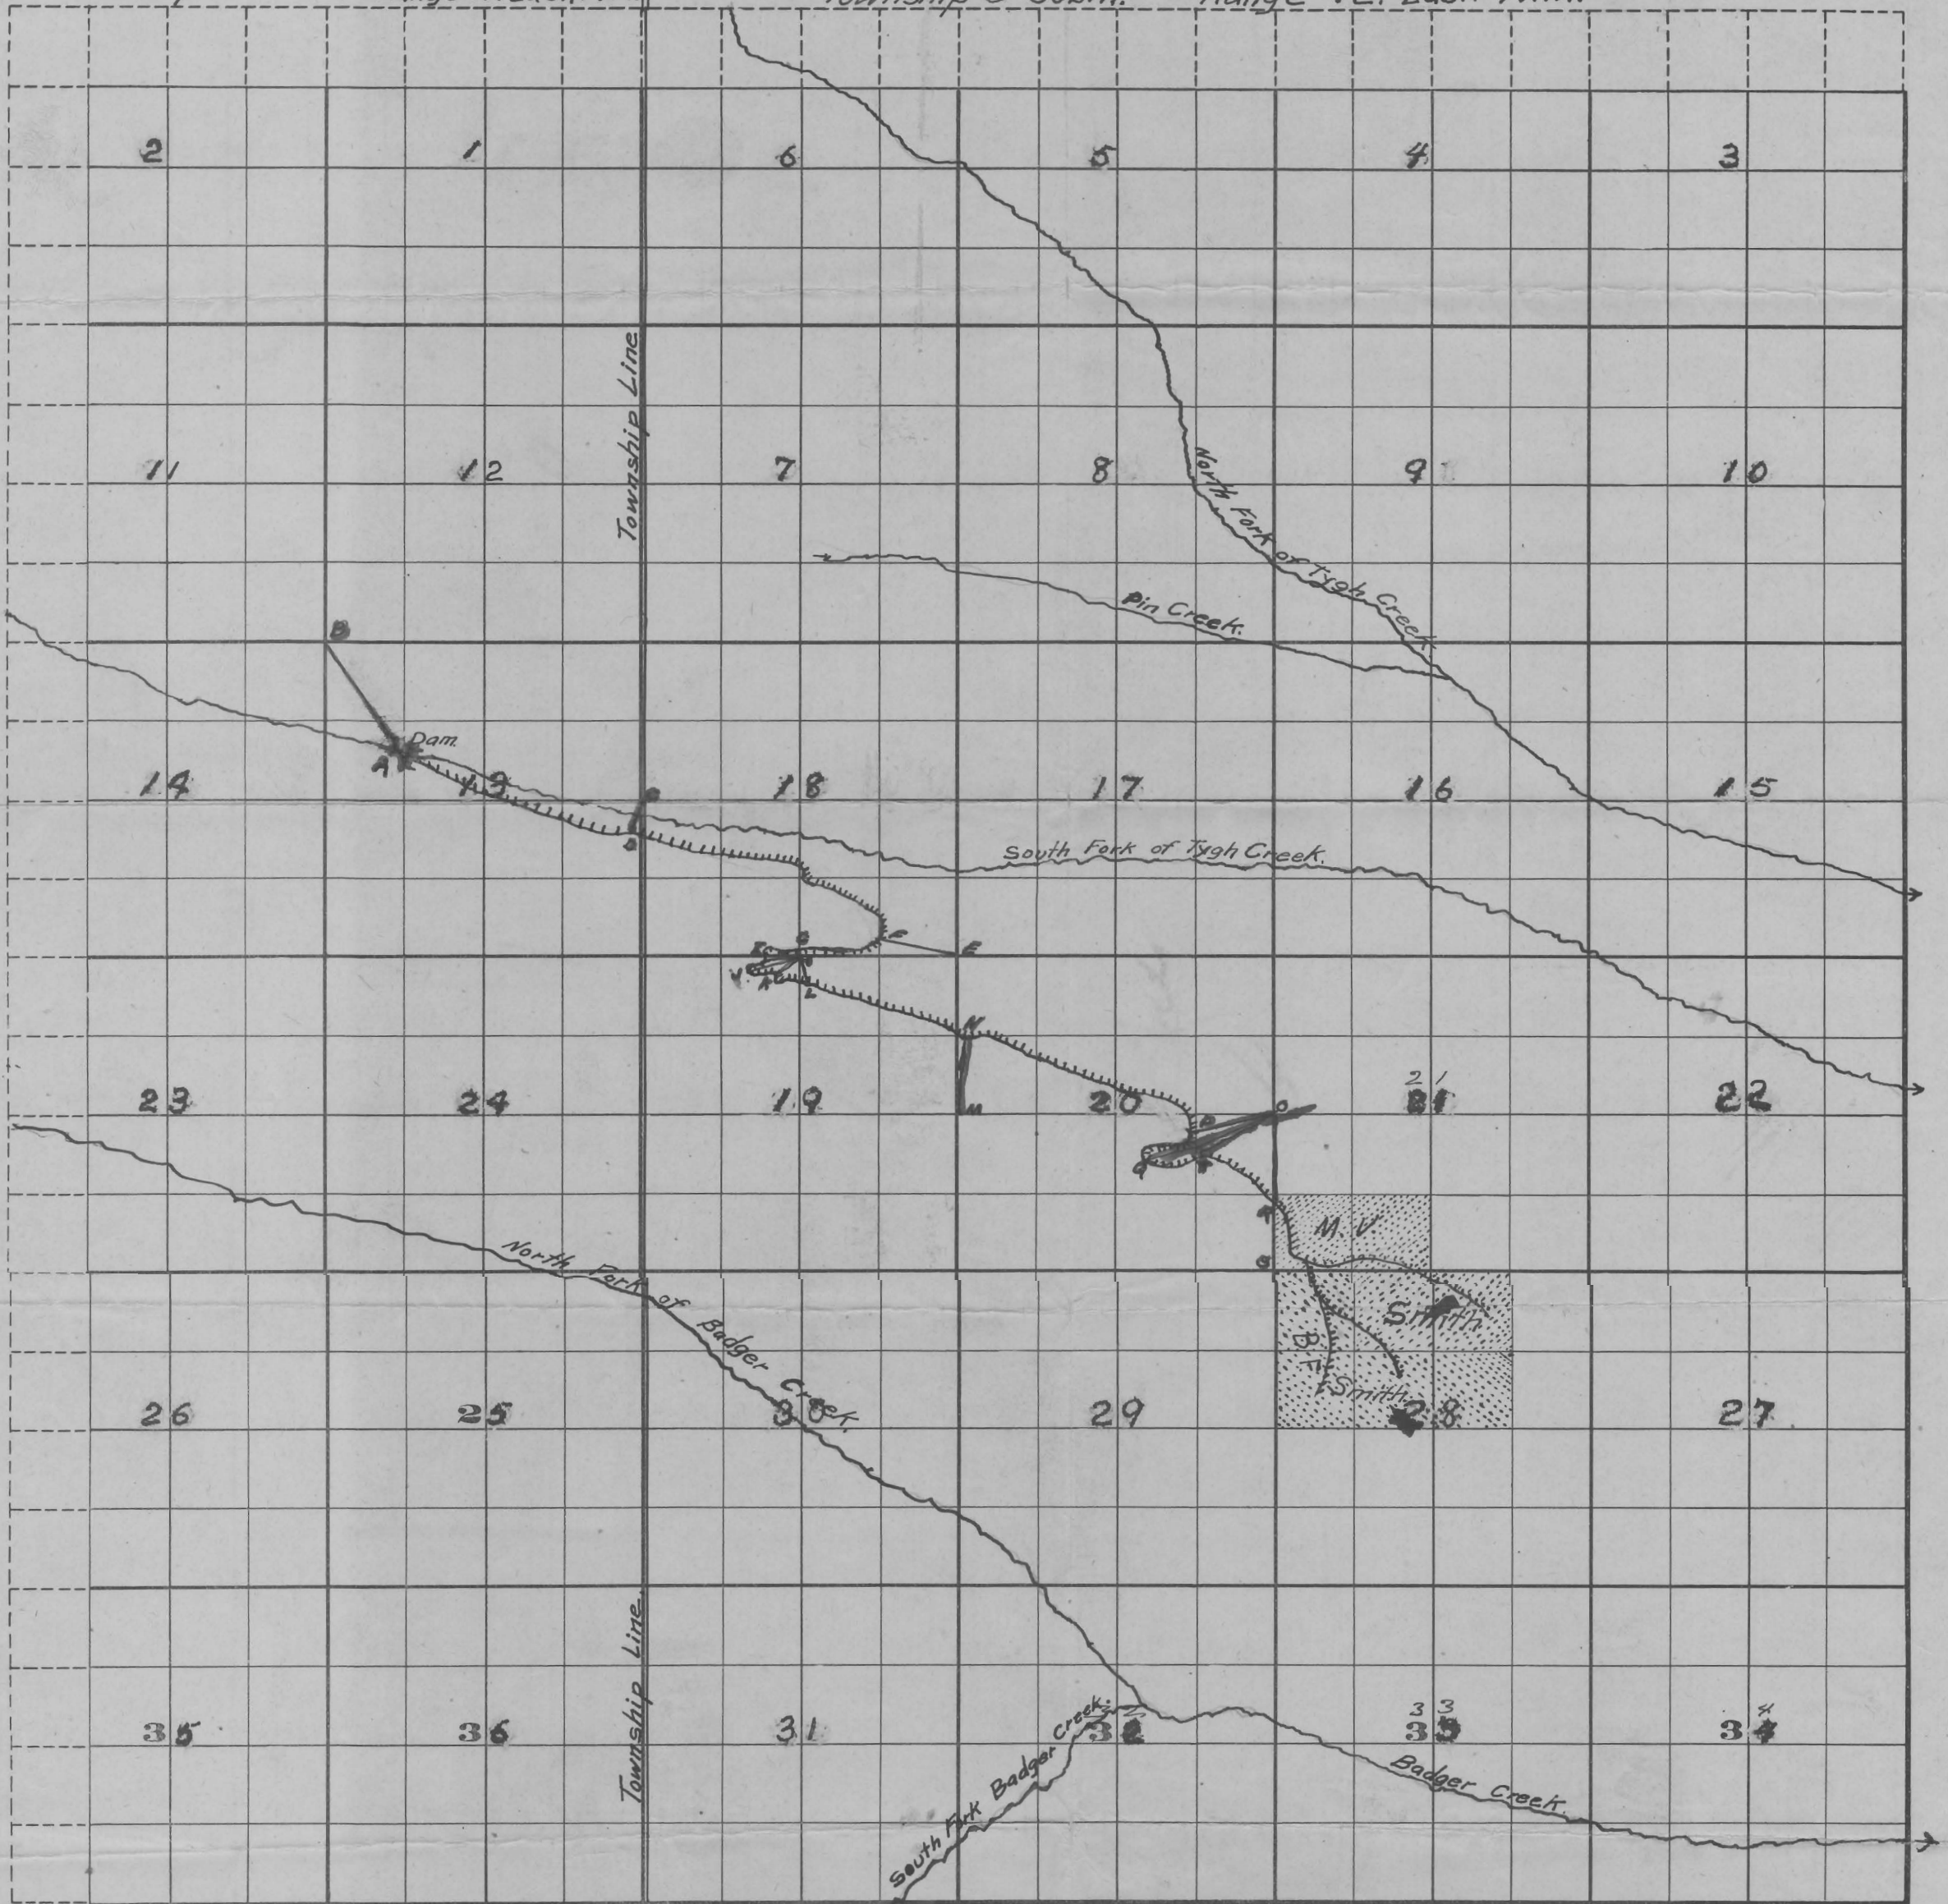

THE S.A. BRISTOL CO., PRINTERS & BOOKBINDERS

FROM OFFICE OF THE STATE ENGINEER, SALEM, OREGON



From Section corner at B to Dam at A.	S. 34° 20' E.	2347.4 feet
From $\frac{1}{4}$ " " " C to point on ditch at D.	S. 6° 12' W.	661.4 feet
From Section " " " E " " " "	F. N. 76° 59' W.	730.1 feet
From $\frac{1}{4}$ " " " H " " " "	G. N. 2° 0' W.	53. feet
From $\frac{1}{4}$ " " " H " " " "	I. S. 81° 36' W.	607.3 "
From $\frac{1}{4}$ " " " H " " " "	J. S. 80° 04' W.	915.8 "
From $\frac{1}{4}$ " " " H " " " "	K. S. 60° 34' W.	498.7 "
From $\frac{1}{4}$ " " " H " " " "	L. S. 13° 14' E.	481.1 "
From $\frac{1}{4}$ " " " M " " " "	N. N. 2° 42' E.	1299.1 "
From $\frac{1}{4}$ " " " O " " " "	P. S. 87° 25' W.	1402.6 "
From $\frac{1}{4}$ " " " O " " " "	Q. S. 76° 19' W.	2206.8 "
From $\frac{1}{4}$ " " " O " " " "	T. S. 63° 30' W.	1388. "
From Section " " " S " " " "	R. N. 0° 0' W.	1245. "

B.F. Smith
Surveyor.

March 4 1912.


Application # 414.
Permit # 182.

Township _____

Range _____

East half of Township 3 South Range 11 East

West half of Township 3 South Range 12 East

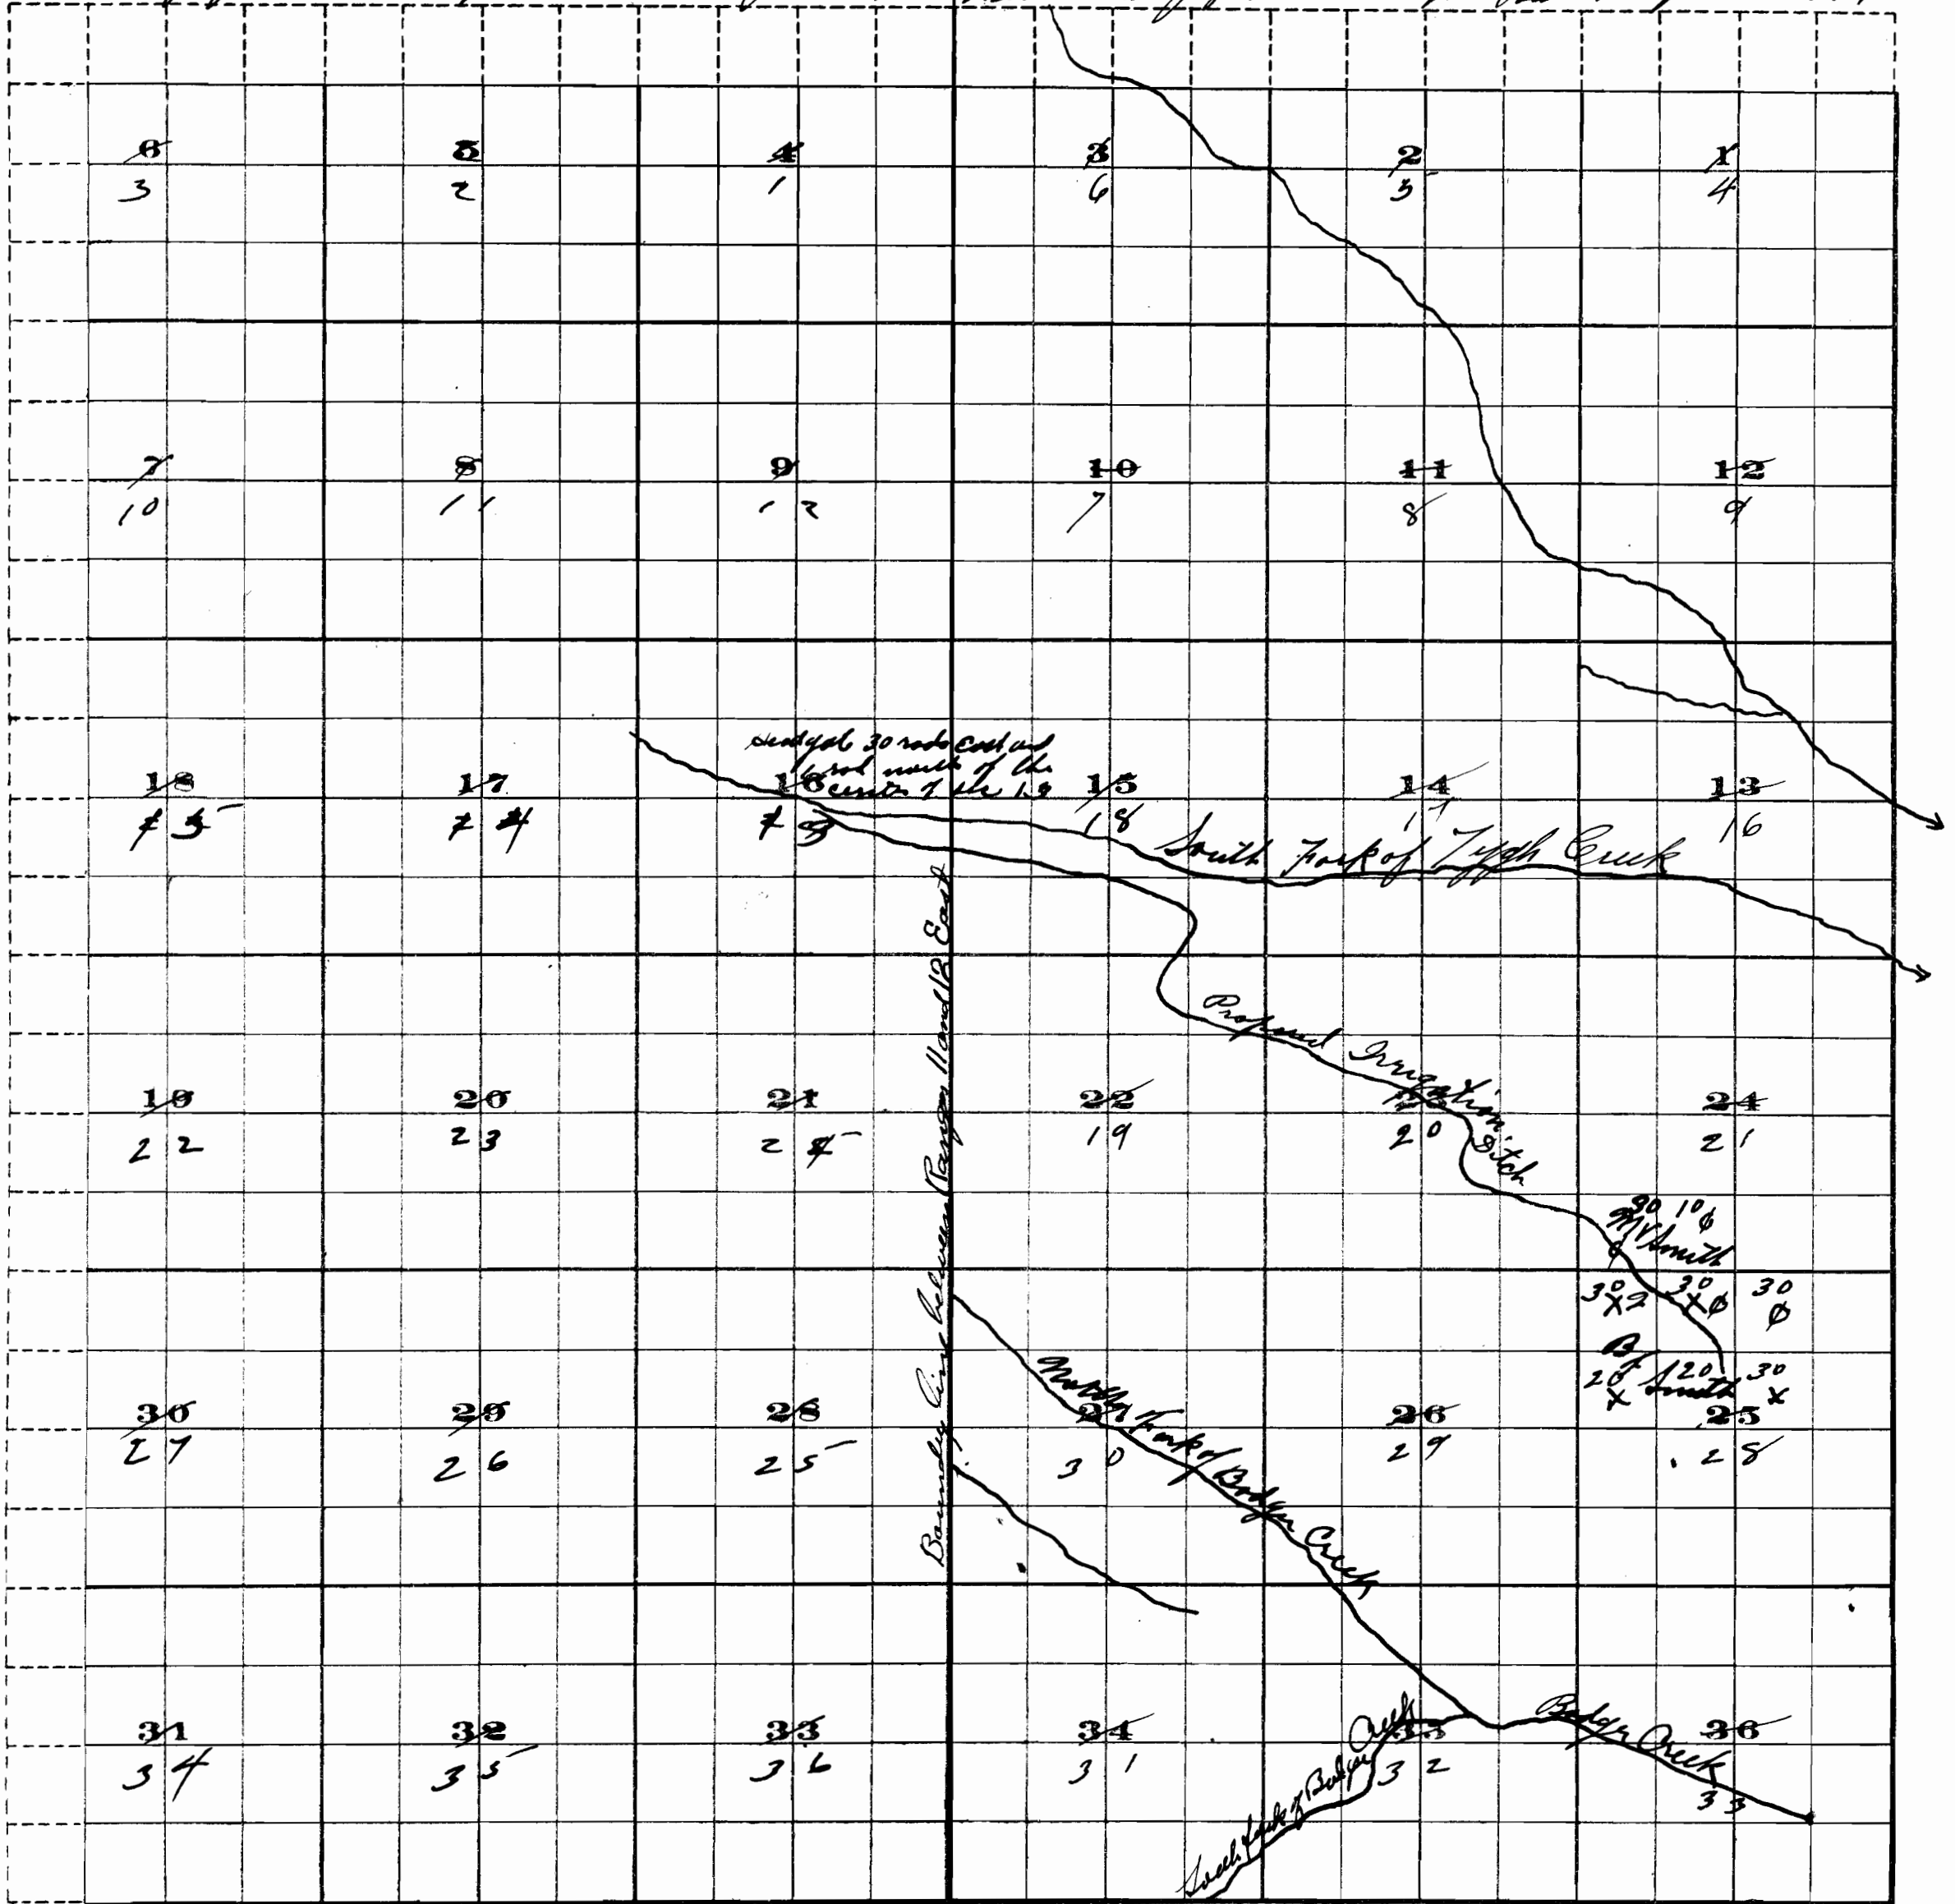

FROM OFFICE OF THE STATE ENGINEER, SALEM, OREGON

Notes to make it more convenient I have divided this map into two parts
 Scale of feet. Mapping the East and West halves of Township 3 South Range 11 and 12 East.
 Application # 414.
 Permit # 182