
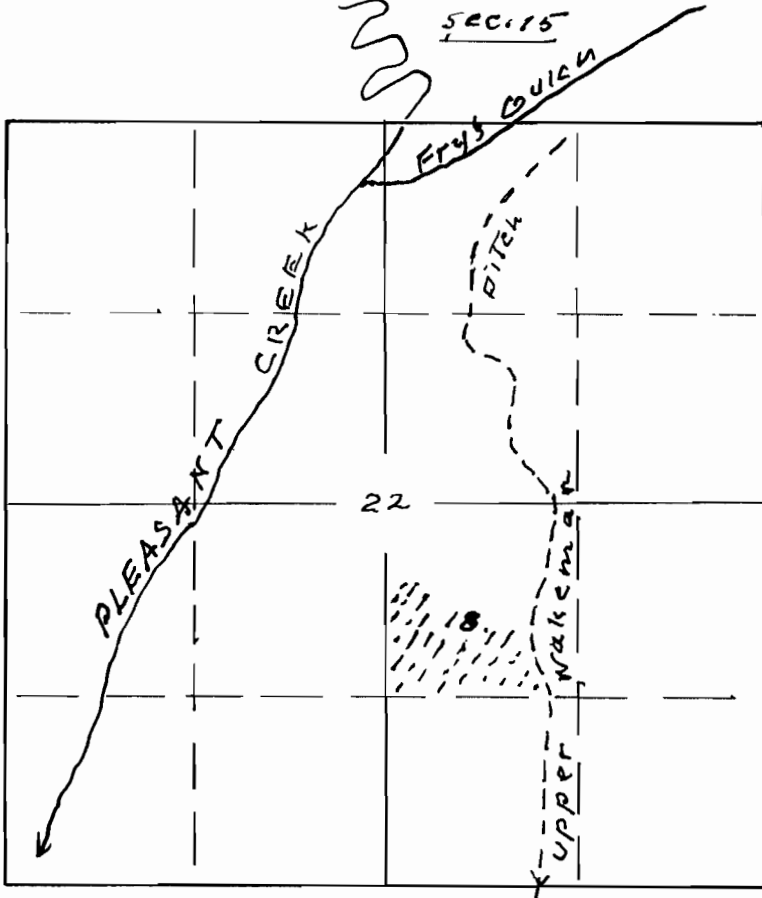


SEC. 22

T. 34. S. R. 4 W. W. W.

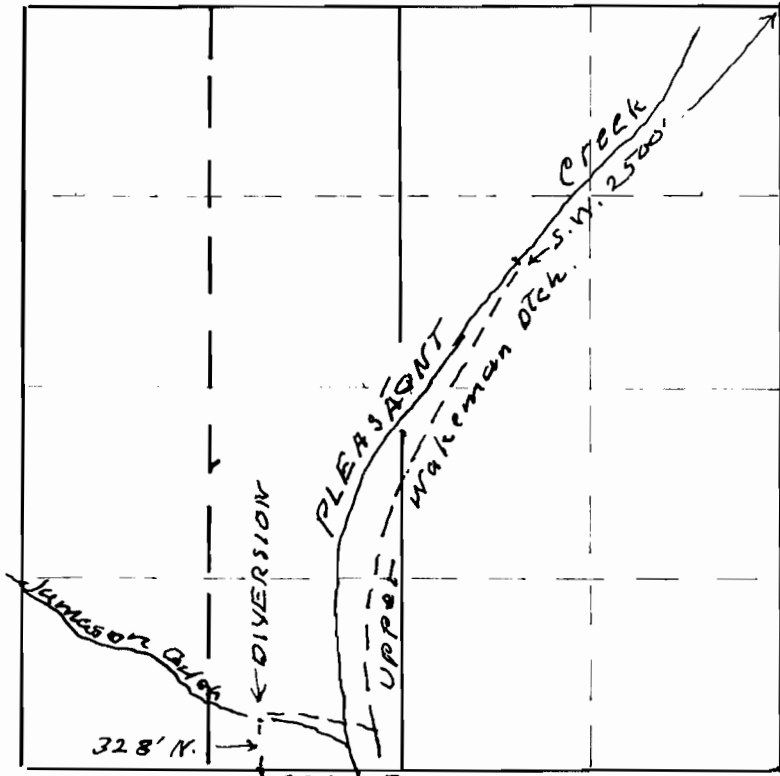

Map to accompany application of
 G. E. Slack for use of water from
 Jamason Gulch for supplemental
 irrigation on lands now watered from
 Pleasant Creek.

Application No. 23107
 Permit No. _____

This office 4/25/25 [Signature]