


Sec. 19

T. 34 S. R. 4 W. W.M.

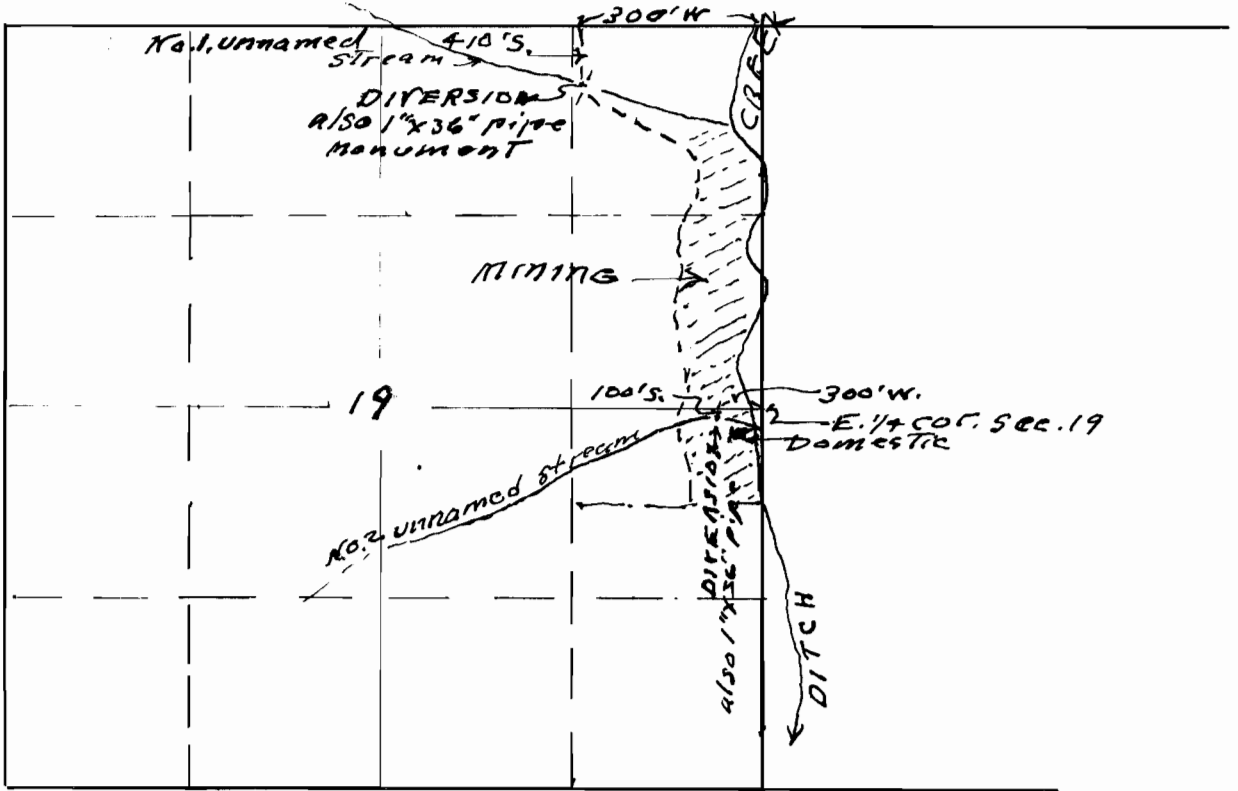

Map to accompany application of  
P.L. Thompson for use of water from  
No. 1 & No. 2 Unnamed streams for  
mining and domestic purposes.

This office 4/14/48 *W. Smith*

Application No. 23136  
Permit No. 44237