


Permit: S 18265
Volume: 4A
Strm: LIMPY CR
Trib: ROGUE R
Priority: 6/02/42

Township 36 S. Range 7 W, R. 14.

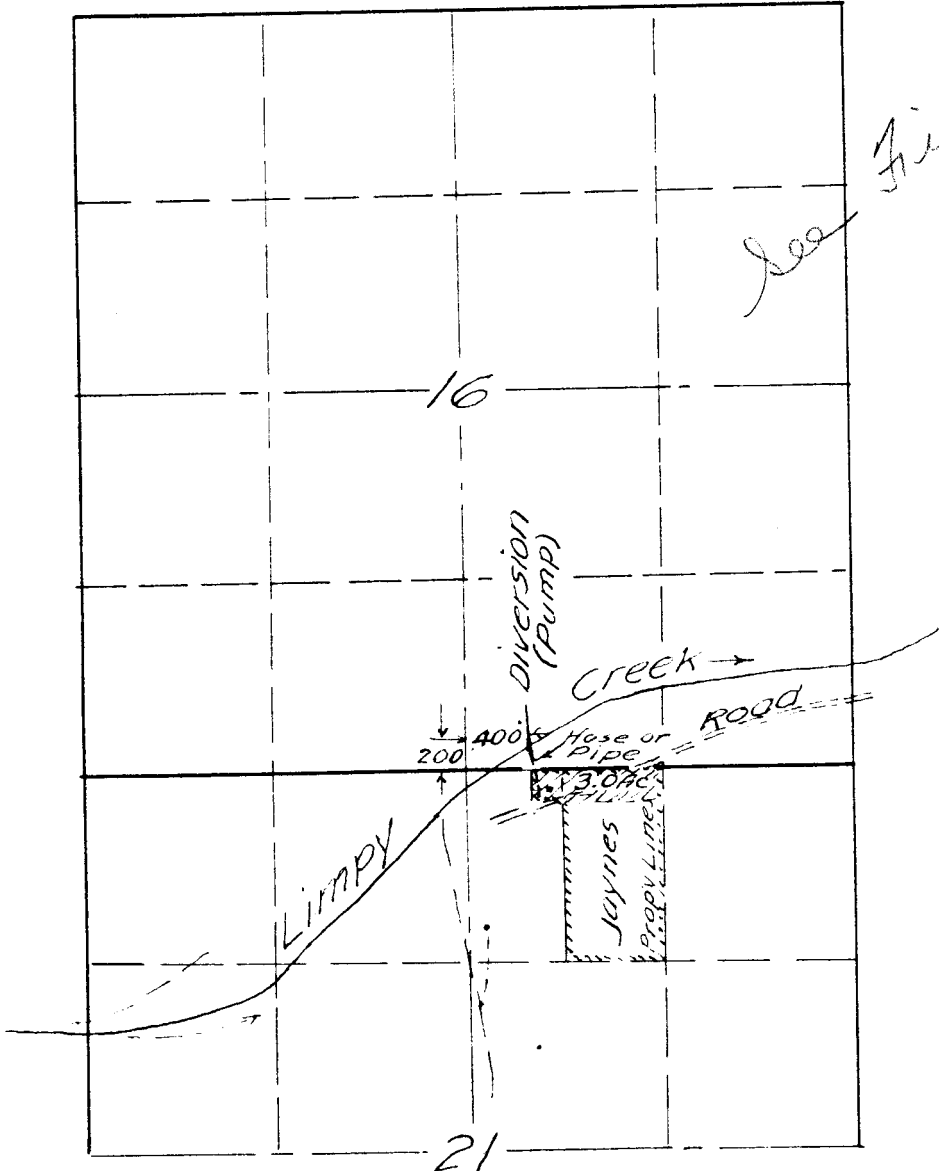

Chas. E. Joynes

Application No. 23217

Permit No. 18 265


SECTION

TOWNSHIP _____, RANGE _____, W. M.

15265

36-7-21

North

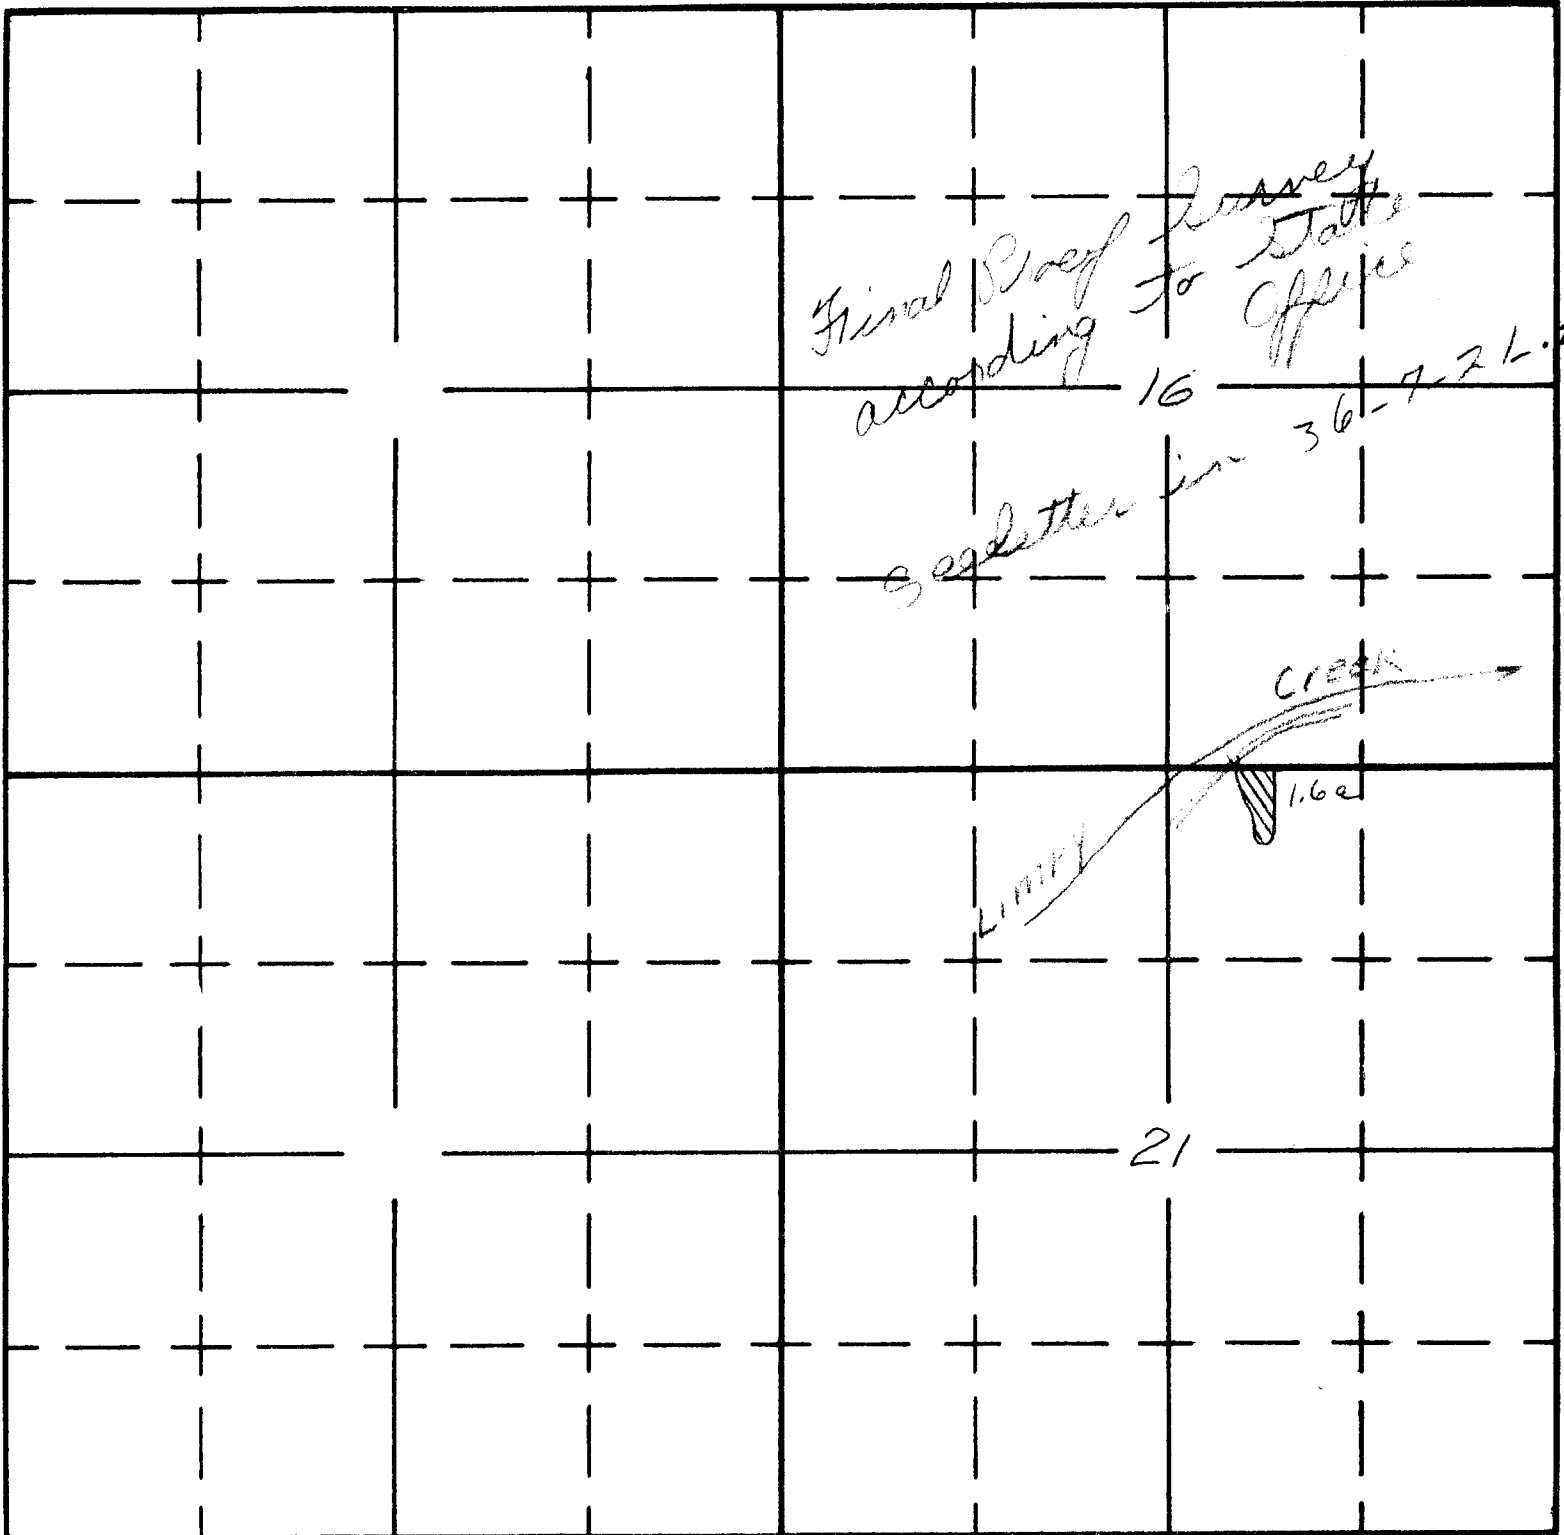

Final Proof to Surveyor
according to State Office

16
See letter in 36-7-21.2

LIMBY
CREEK
1.62

21

South

APPLICATION No.

PERMIT No.