


MAP  
 Showing location of spring,  
 pipe line, place of use  
 Application #21309  
 by  
 J. F. HURT  
 December 24  
 1945

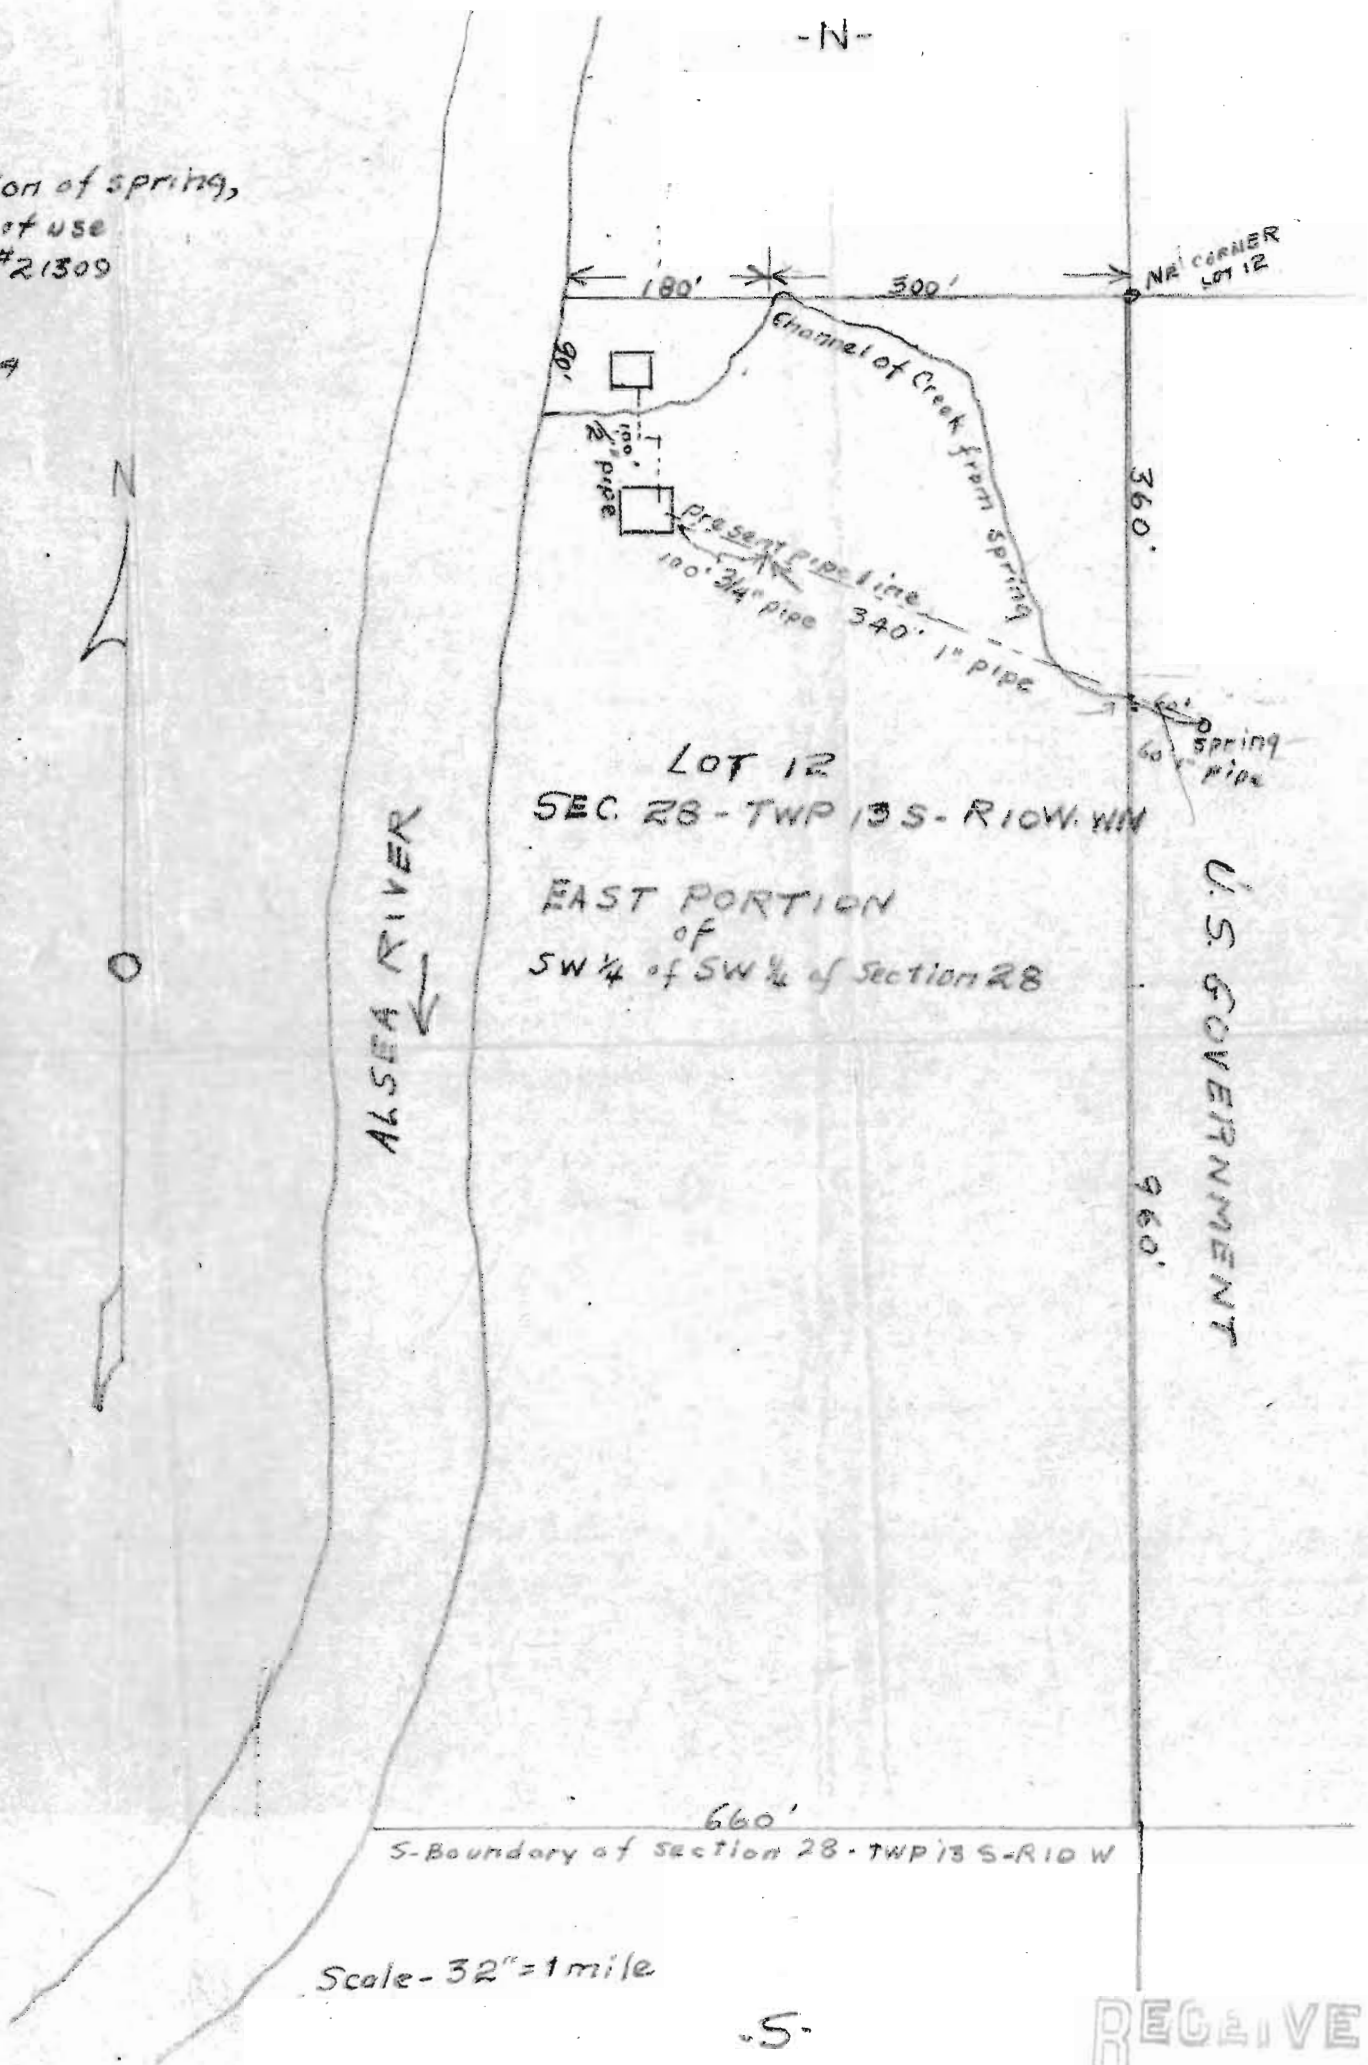

RECEIVED  
 JAN 7 1946  
 STATE ENGINEER  
 SALEM, OREGON

Application No. 21309  
 Permit No. 18-12