Sec. 11, T. 35 S. R. 4 W. W.M.

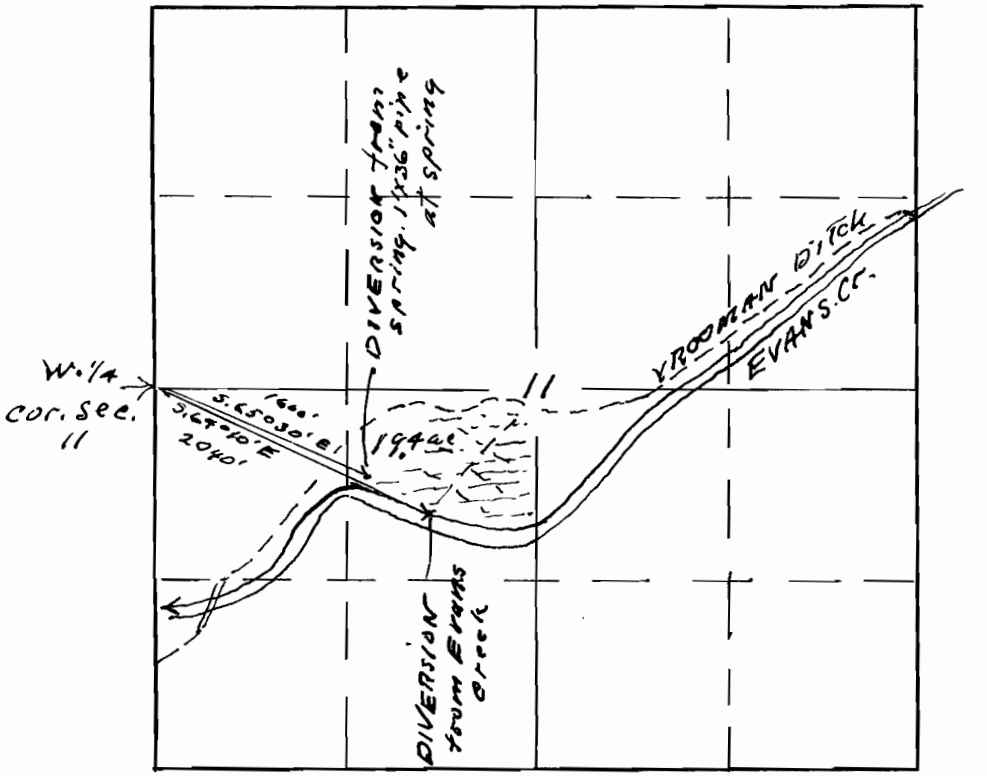

Map to accompany application from water of private spring and Evans Creek, for irrigation purposes.

Application No. 23115
Permit No.

This office 5/7/85