


T. 37 S., R. 7 W., W. M.
Scale 400' = 1" July 1948

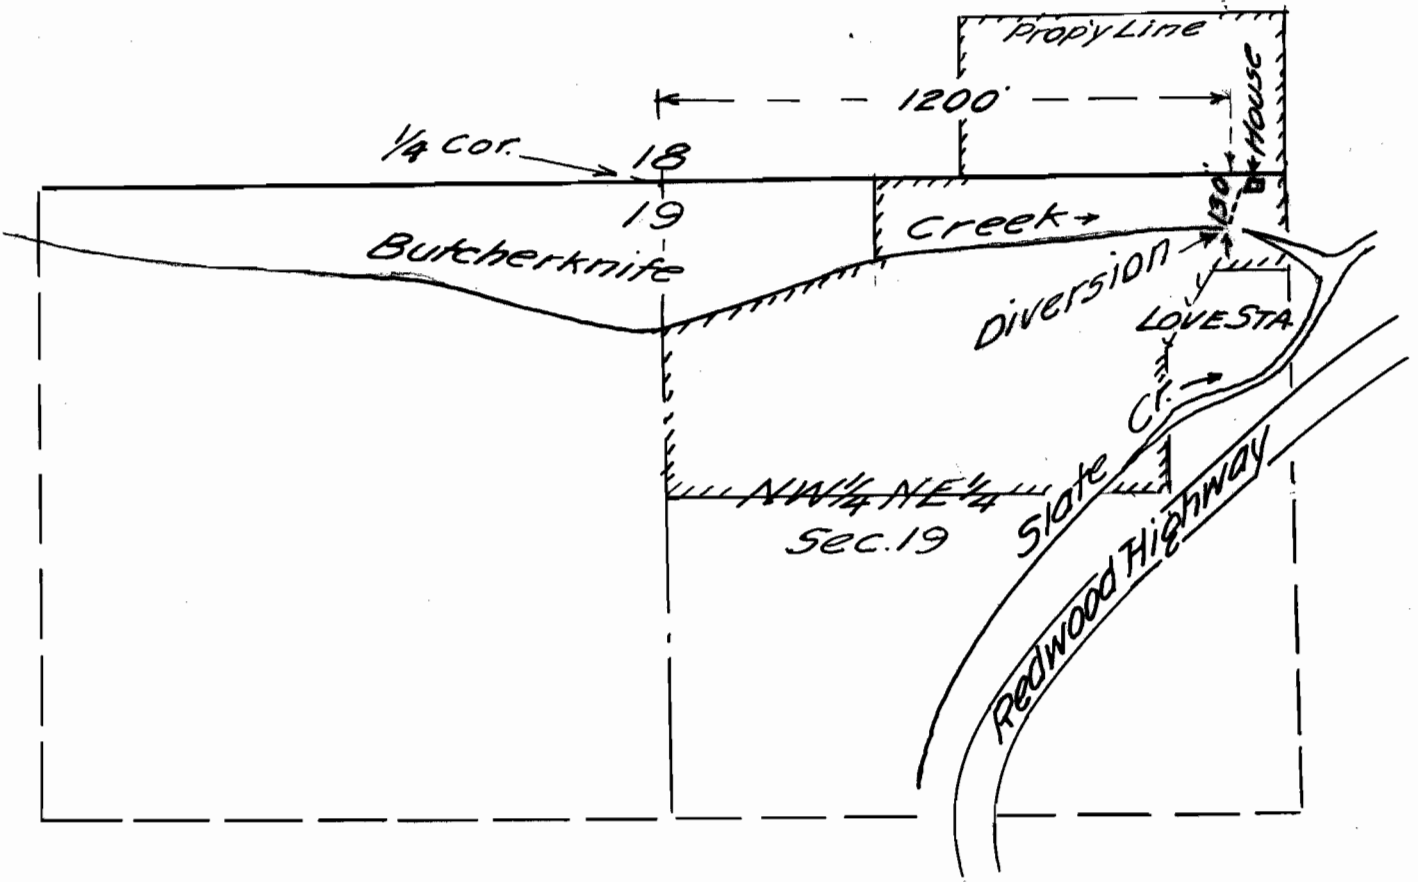

R. W. Almquist

Application No. 23271 -

Permit No. 18365

RECEIVED

STATE ENGINEER
SALEM, OREGON

23271

15-16D