


Sec. 19, T. 33 S., R. 1 W. W.M.

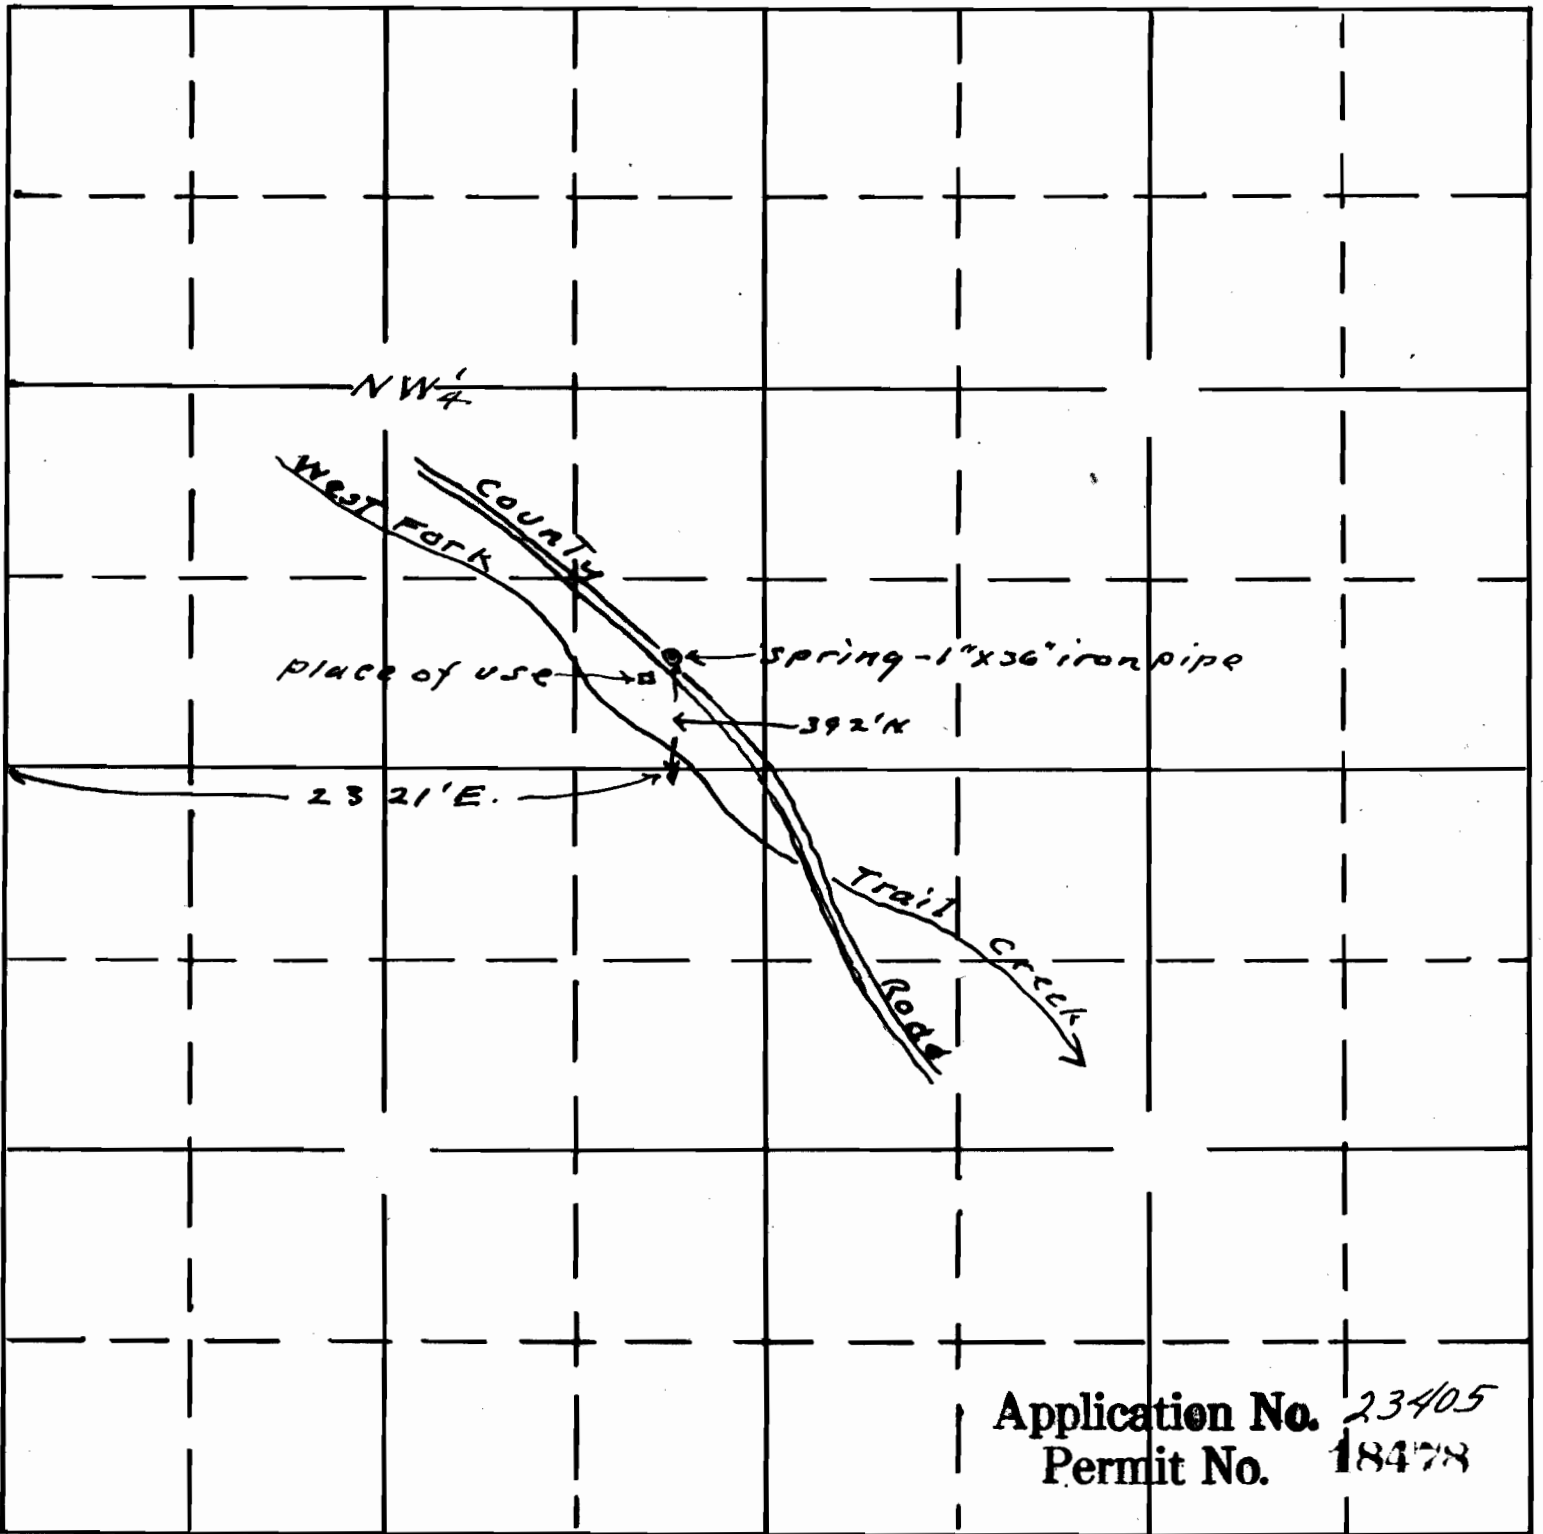

Application No. 23405
Permit No. 18478

Map to accompany application of
Laurence Sellers for use of spring
water for domestic purposes.

This office 9/7/48 *[Signature]*

23405

15-78F