


T.17S. R.21&22S WM

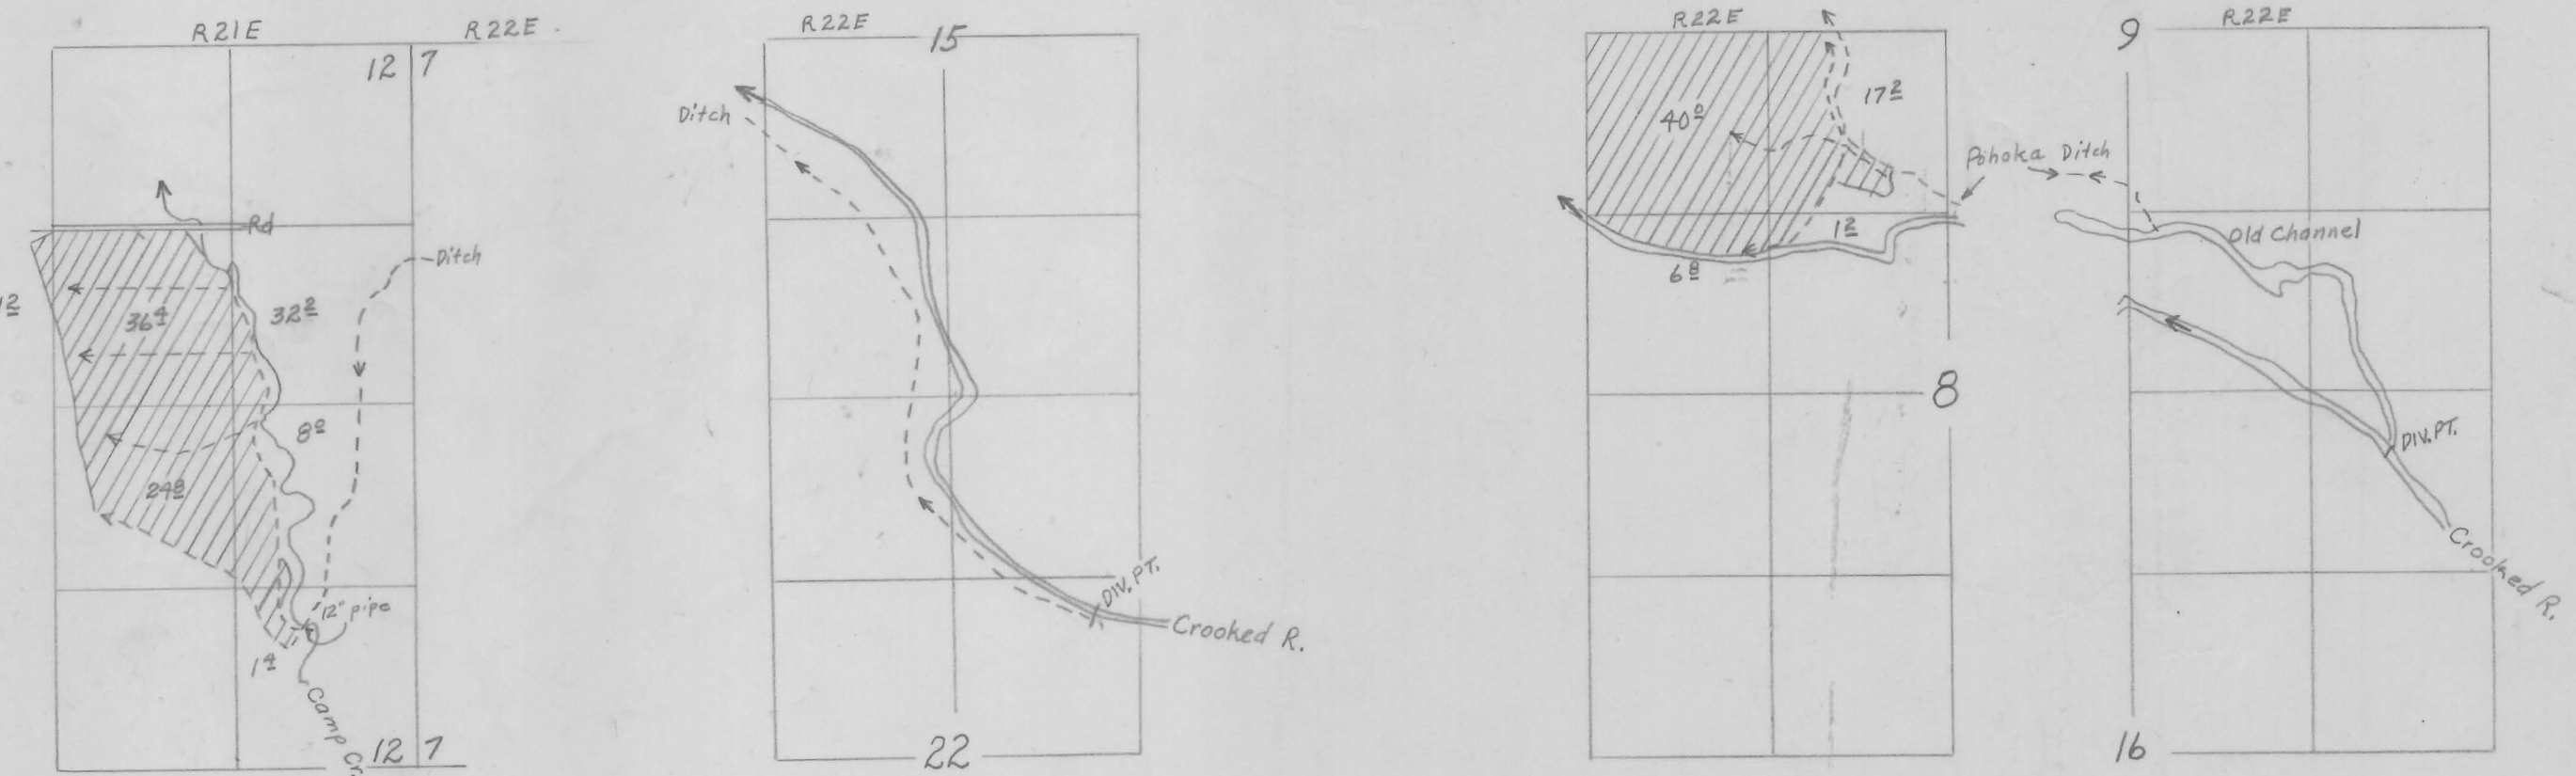

FINAL PROOF SURVEY

UNDER

Application No. 23408 Permit No. 18479

IN NAME OF

Mary Glenn Butler

Surveyed Apr 24 1955, by T. Jones