


Everett E. Robinson,
 T.36 S., R.6 W., W.M.
 Scale 4" = 1 Mile Sept. 1948

Wilderville Ditch
 3 miles (nd to scale)
 See Rejudication Survey Map
 Rogue River and Trib.

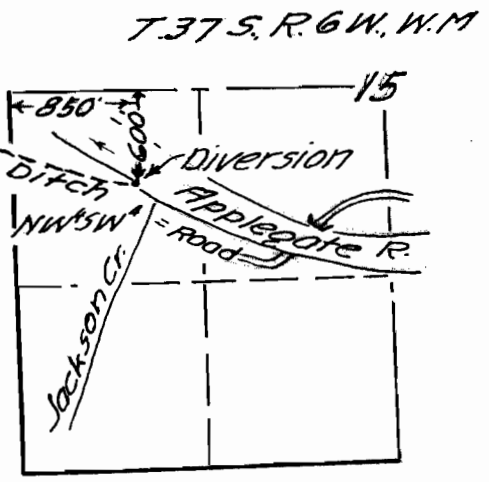

Application No. 23454
 Permit No. 15000

23454