


Sec. 26. T. 38 S., R. 4 W. W.M.

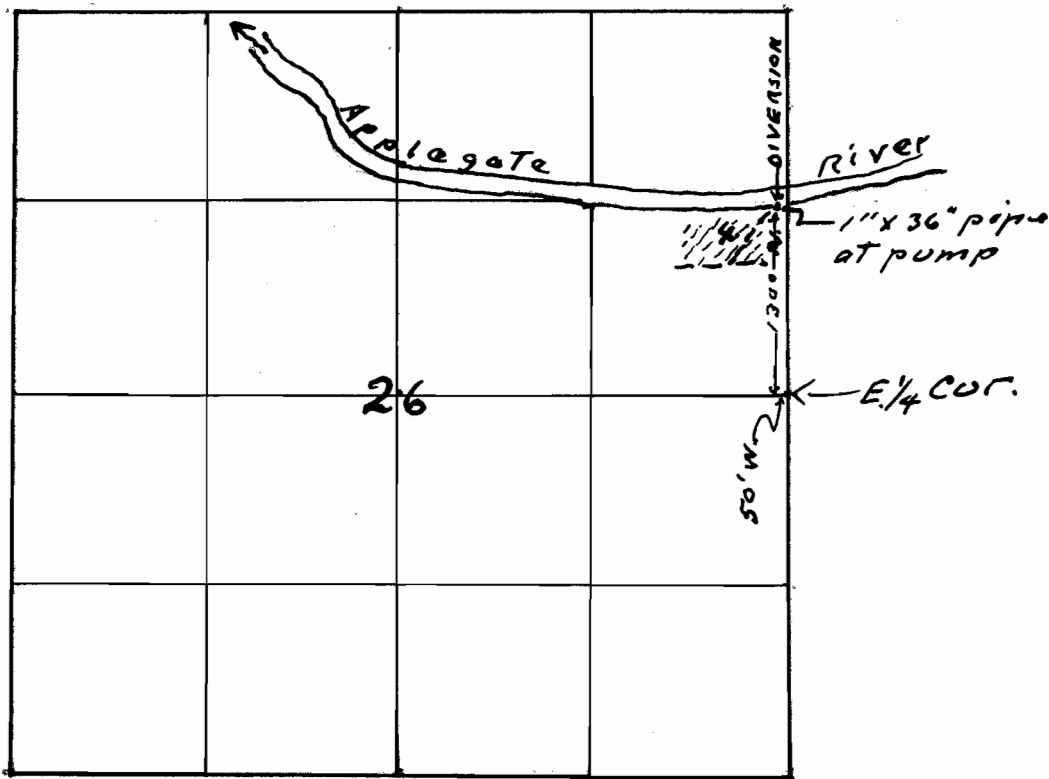

Map to accompany application of
Jesse A Wilcox for use of water
from Applegate River for
irrigation purposes.

Application No. 23498
Permit No. 18529

This office 10/26/48 *Shmidt*