


Sec's. 7-12. T. 35S. R. 1 & 2 W.W.M

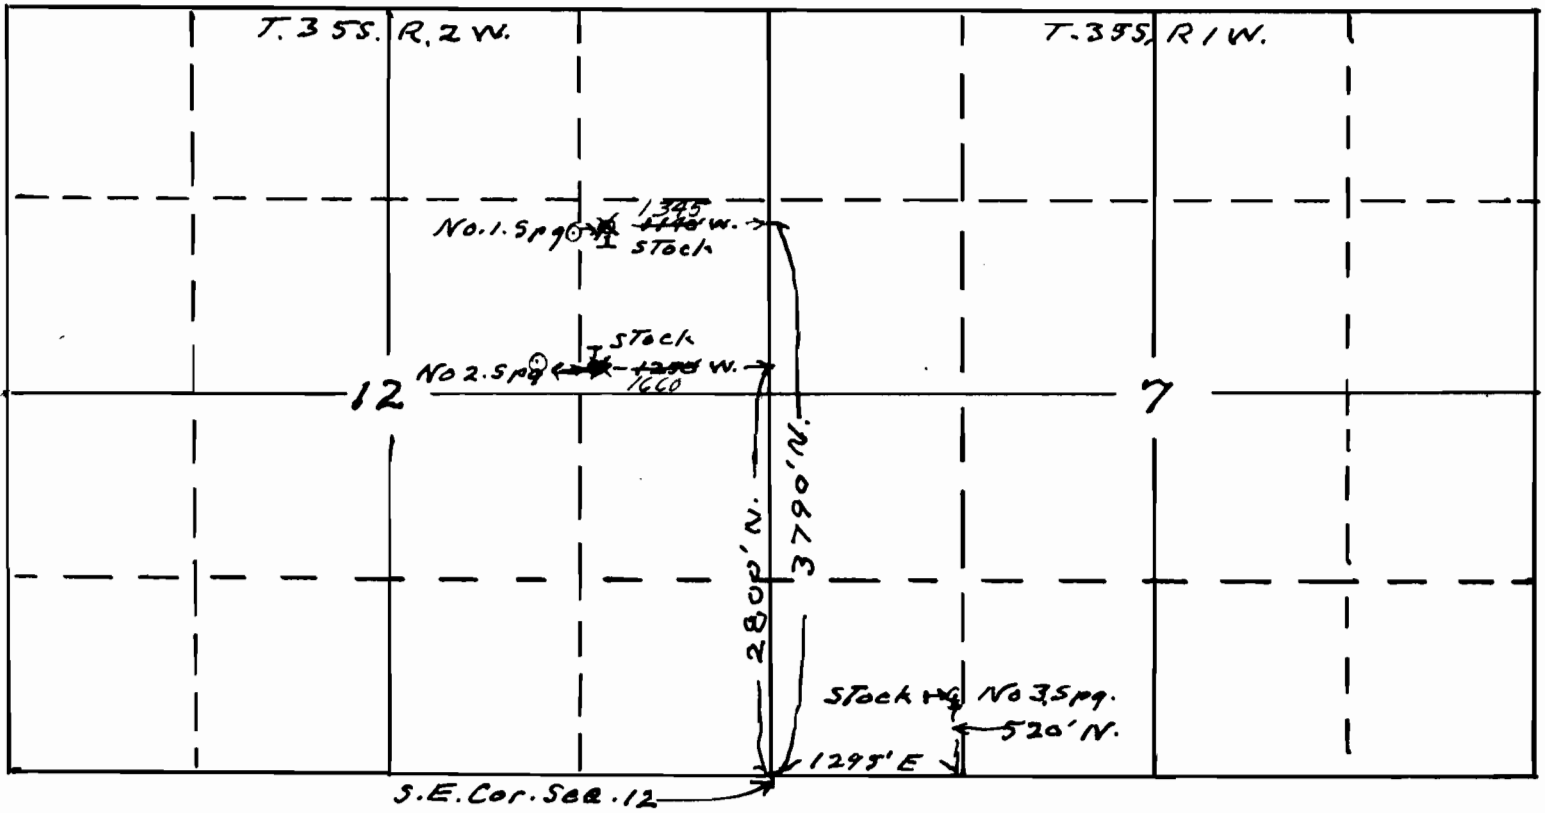

Map to accompany application of
Margarite Wood for use of three
private springs for stock purposes

This office 10/27/48 *Smith*

Application No 23541
Permit No. 18588