


Sec. 15, T. 39 S., R. 1 E. W. M.

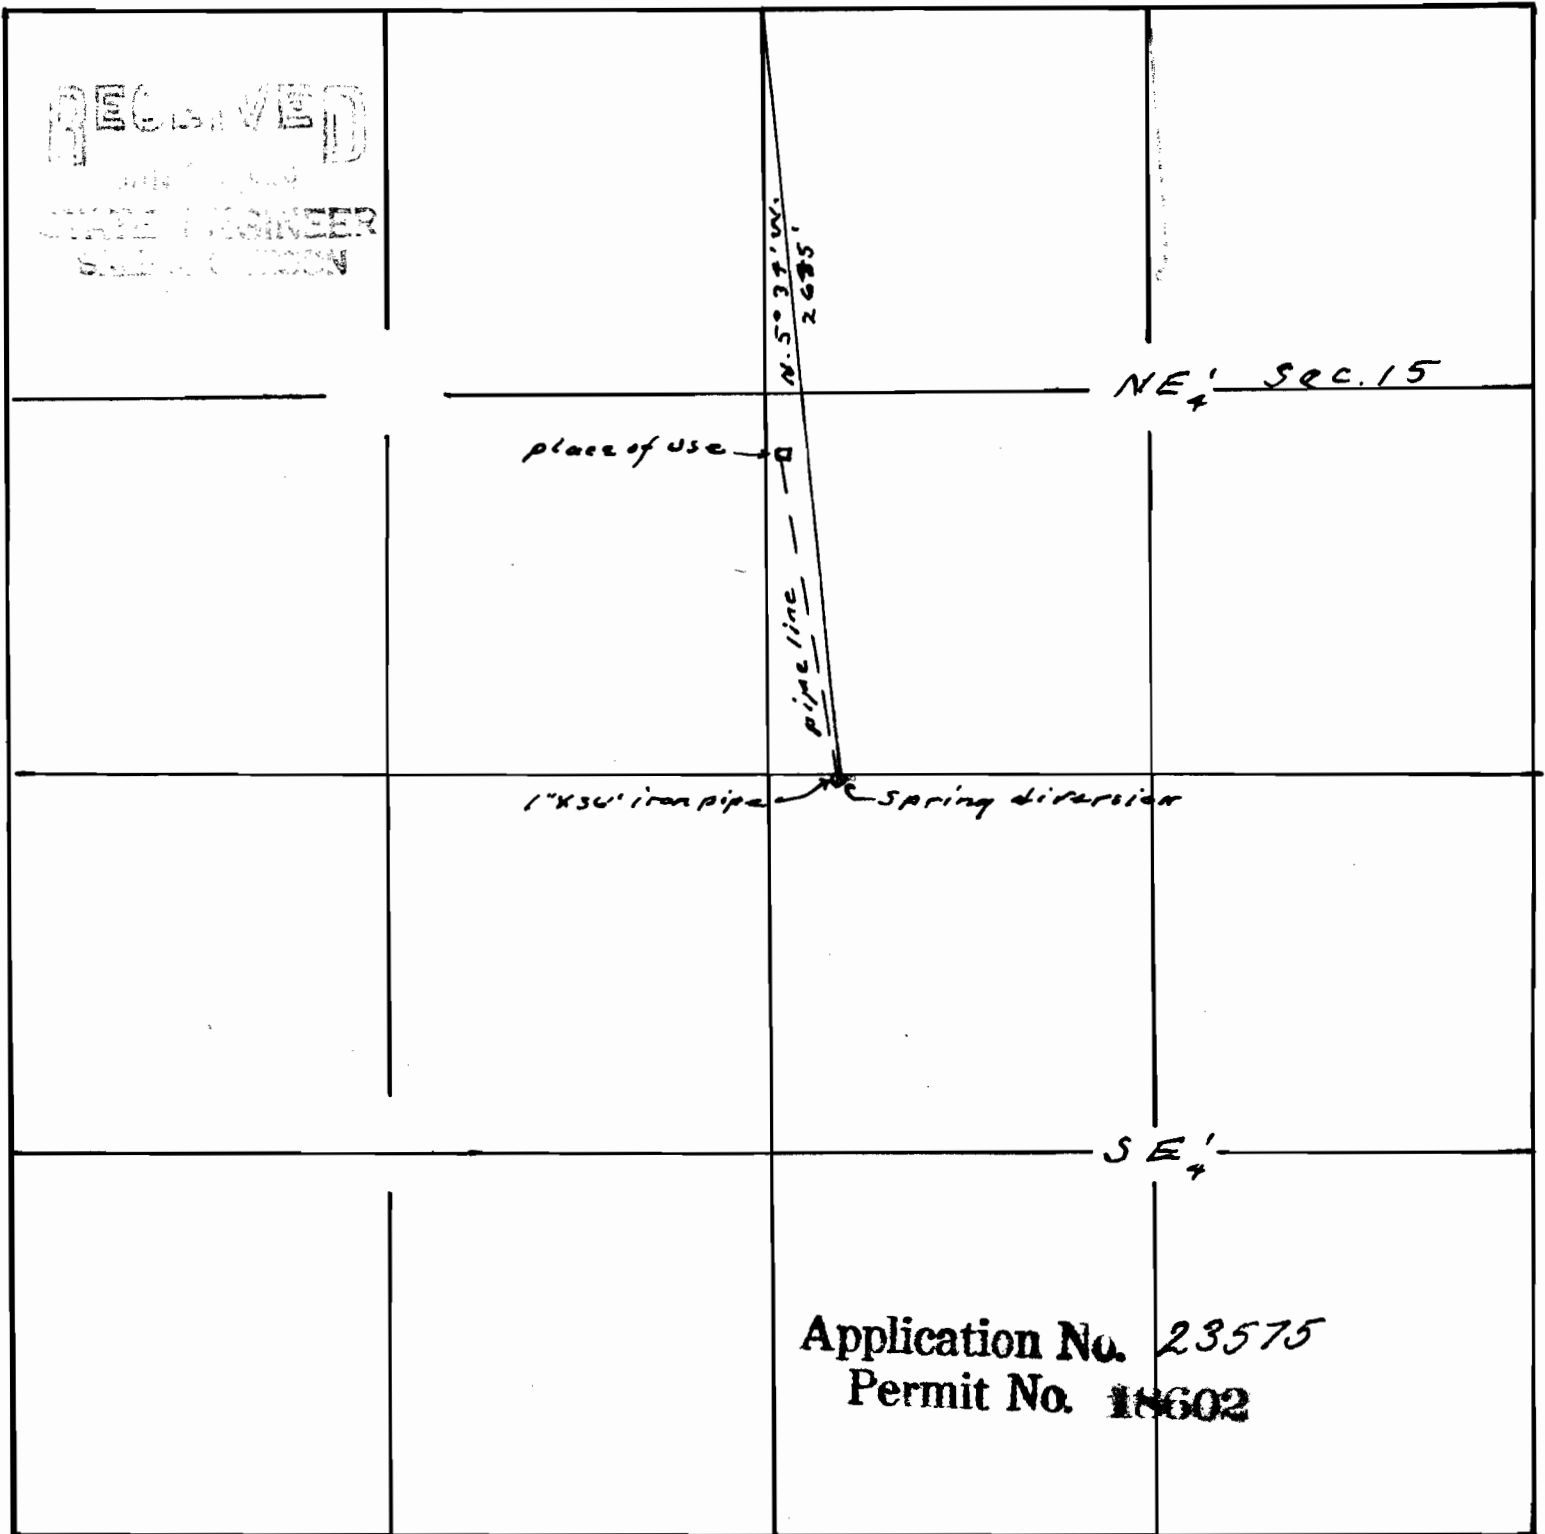

Map to accompany application of
Fred H Mosier for use of water from
private spring for domestic use

This office 1/5/49 *Ch. Smith*

23575

15-24